3:00

203654 → replaced by 206007

IREDELL COUNTY HEALTH DEPARTMENT - *ENVIRONMENTAL HEALTH* ☐ STATESVILLE OFFICE 704-878-5305 ~~☐ MOORESVILLE~~ OFFICE 704-664-5281

IMPROVEMENT PERMIT / AUTHORIZATION TO CONSTRUCT / OPERATION PERMIT / EXISTING SYSTEM INSPECTION

PERMIT # 168056 PIN # 4629-94-3276 DATE SEPTEMBER 22, 2011

OWNER John Woody APPLICANT: PRESTIGE BUILDERS PHONE: Home/Cell # 704-746-6497 Business # 704-664-2671

SITE ADDRESS 491 STILLWATER ROAD OWNER / APPLICANT ADDRESS 491 STILLWATER ROAD

SITE DIRECTIONS STATE PARK RD TO MORRISON FARM RD, TL DAYVAULT CUT TR STILLWATER, LOT ON (L) AT #491

SUBDIVISION CL&T BLOCK / SECTION 17 LOT # 64 LOT AREA 0.82 ACRE DESIGN FLOW 480 L.T.A.R. 0.30 GPD/FT²

Septic Tank 1000 Gallons: STB 760-1000 Date 6-3

Pump Tank ____ Gallons: PT ____ Date ____

Pump Make ____ Model ____ Serial # ____

No. Nitrification Fields: 1 No. Lines 5 IX Linear Feet 270

Trench Width 24" Max. Trench Bottom Depth 36" SAND Gravel Depth 24"

☑ New System ☐ Repair ☐ Expansion System Type I II (III) IV V VI

System Description: 50% REDUCTION GRAVITY

Repair System Description: 50% REDUCTION LOW PRESS

Maintenance Agreement Required ☐ YES ☑ NO Pretreated

☑ GRAVITY ☐ PRESSURE

☑ Residence ☐ Business ☐ Other ☐ Slab ☑ Basement w/plumbing


No. Bedrooms 4 No. Persons ____ No. Employees ____ ~~☑ Crawl Space~~

☐ Basement w/o plumbing

Water Supply: ☑ Private WELL ☐ Public ☐ Community

Comments / Conditions ① GRADE SITE ACCORDING TO ATTACHED GRADING PLAN PRIOR TO ISSUANCE OF AUTHORIZATION TO CONSTRUCT ② INSTALL 50% REDUCTION SYSTEM AS SHOWN USING 60 PPBPS PANELS IN 6 EQUAL LENGTH LINES, ③ USE ONE FLOW DIVIDER TEE AND TWO EFFLUENT SPLITTERS TO ACHIEVE EQUAL DISTRIBUTION INTO EACH LINE.

INITIAL SITE SKETCH

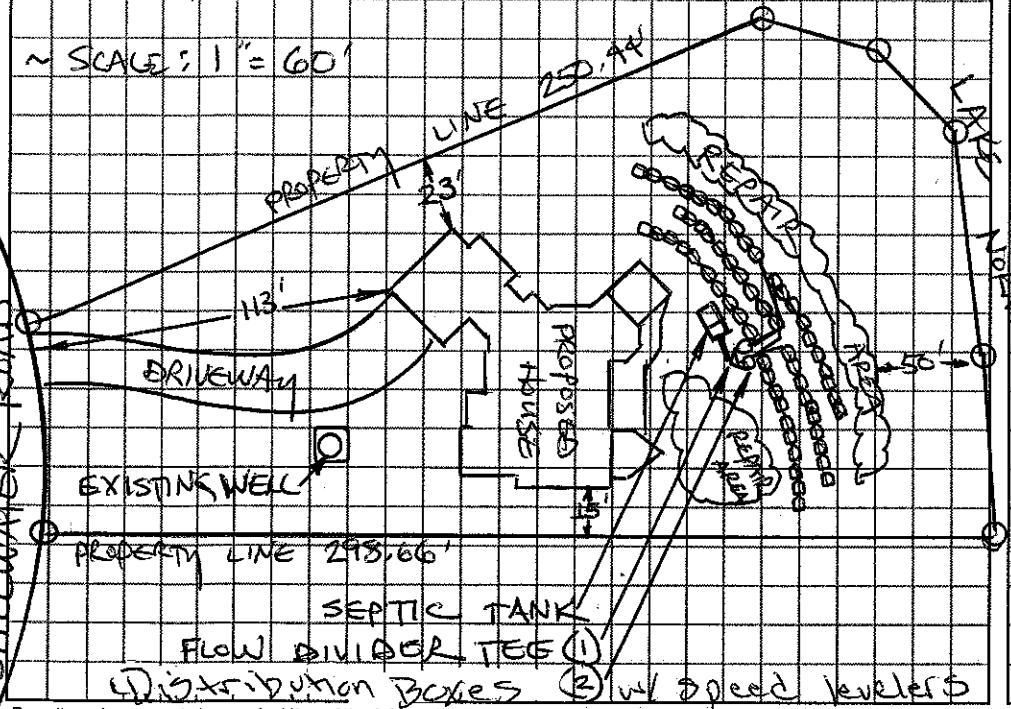

AS BUILT SKETCH

- Red Polylok Filter installed
- Installed as Drawn
- 2 old Drainfield lines were not during installation, ends were cut & capped
- System was all installed on same grade.

Permit can be suspended or revoked if any false information is supplied toward securing the permit / any unauthorized changes are made to the site / any unauthorized changes are made in the installation of the system.

☐ ***IMPROVEMENT PERMIT*** with plat valid without expiration. ☒ ***IMPROVEMENT PERMIT*** with plat valid without expiration. ***site plan valid 60 mo.*** ☒ ***AUTHORIZATION TO CONSTRUCT*** valid for period equal to IMPROVEMENT PERMIT--not to exceed 60 mo.

Owner / Applicant Signature John Woody Date 10-17-11 Installed by: A1-Backhoe

IMPROVEMENT PERMIT by: R. STEVE HEDRICK REHS Date 9-22-2011 OPERATION PERMIT by: Justin Henderson REHS Date 11-24-15

AUTHORIZATION TO CONSTRUCT by: John H. Lowe REHS Date 6-03-2014 Existing System Inspected by: ____ REHS Date ____

YOU SHOULD CONTACT A LOCATOR SERVICE PRIOR TO ANY EXCAVATION

White Copy – Environmental Health YELLOW COPY (Final) Owner / Applicant PINK COPY (Initial) Owner / Applicant