IREDELL COUNTY HEALTH DEPARTMENT

Statesville Office (704) 878-5305 Mooresville Office (704) 660-3625 PERMIT # 170653

IMPROVEMENT PERMIT / AUTHORIZATION TO CONSTRUCT / OPERATION PERMIT / EXISTING SYSTEM

PIN # 4629944395

APPLICANT: Nelson Dellinger Building APPLICANT ADDRESS: 170 Pisgah Church Rd

SITE ADDRESS: 489 Stillwater Rd, PHONE: 704-902-0429 ALT. PHONE: N/A


SITE DIRECTIONS: Hwy 215 TR Perth Rd. TR State Park Rd. TL Morrison Farm Rd TL Stillwater Rd.

SUBDIVISION: CL+T SECTION: 17 LOT # 65 LOT AREA: 0.68 acres DESIGN FLOW: 360 gpd L.T.A.R.: 0.3

Septic Tank	1000 (gal)	STB	1012	Date	11-1-12	☐ New System ☐ Repair ☑ Expansion	System Type: I II ☒ III IV V VI	☑ Residence	No. Bedrooms	3	Water Supply
Pump Tank	(gal)	PT		Date		System Description:	25% Reduction	☐ Business	No. Persons		☑ Private
Pump Make		Model		Serial #		Repair System Description:	25% Reduction w/ Pretreat.	☐ Other	No. Employees		☐ Public
# Nitrification Fields	1	# Lines	2	Linear Ft:	100	Maintenance Agreement Required:	☐ YES ☑ NO	☐ Slab	☑ Crawl Space		☐ Community
Trench Width	36"	Max. Trench Bottom Depth	36"	Gravel Depth	N/A	☑ GRAVITY	☐ PRESSURE	☐ Basement w/plumbing			☐ Basement w/o plumbing

Comments / Conditions: IMPROVEMENTS ONLY! Submit floor Plan prior to issuance of CA. Install 100' of 25% Reduction on contour with serial distribution. Install New drainlines @ location shown below + connect to existing bed drainfield as shown below. Pump & crush existing septic tank. All components of septic tank system are at least 90' away from existing well.

INITIAL SITE SKETCH

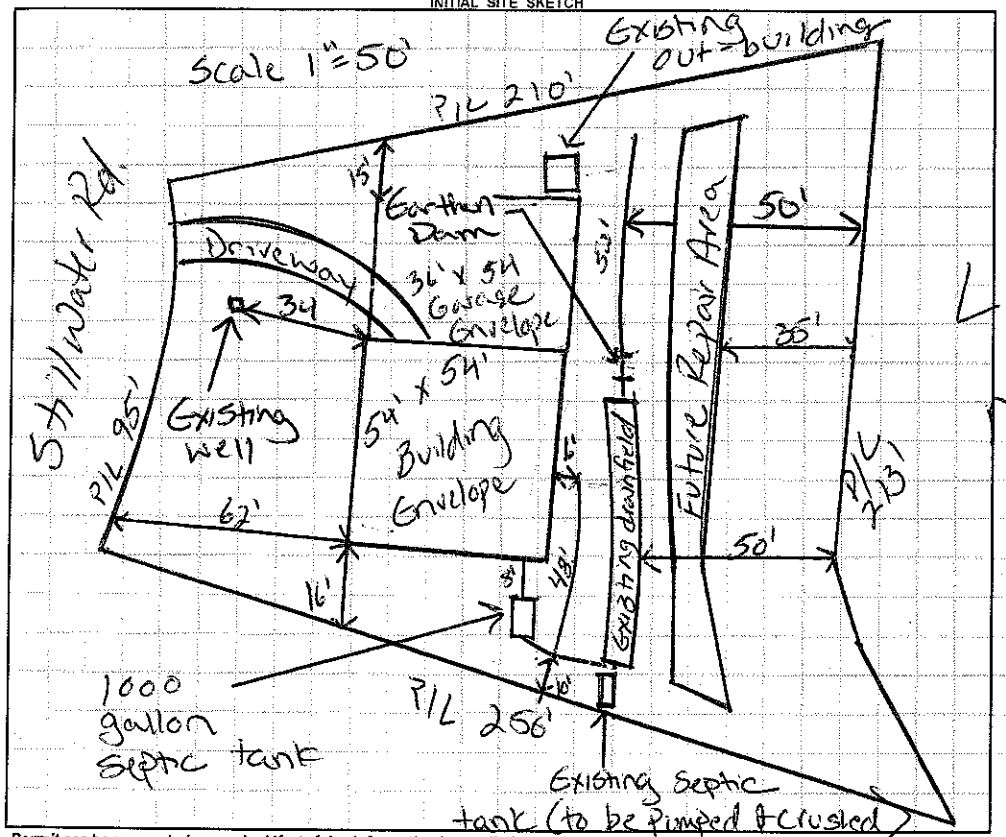

AS BUILT SKETCH

House not in place when system installed

Permit can be suspended or revoked if any false information is supplied toward securing the permit / any unauthorized changes are made to the site / any unauthorized changes are made in the installation of the system. **CONTACT A LOCATOR SERVICE PRIOR TO ANY EXCAVATION**

☐ **IMPROVEMENT PERMIT** ***with plat*** *valid without expiration* ☑ **IMPROVEMENT PERMIT** ***with site plan*** *valid for 60 mos.* ☐ **AUTHORIZATION TO CONSTRUCT** *valid for period equal to IMPROVEMENT PERMIT--not to exceed 60 mo.*

Owner / Applicant Signature: Date: 9-3-13 Installed by: Figo Grading

IMPROVEMENT PERMIT by: Justin Rekenthaler Date: 7-18-13 OPERATION PERMIT by: Date: 9-5-13

AUTHORIZATION TO CONSTRUCT by: Date: 9-3-13 Existing System Inspected by: Date:

Health Dept. Copy - WHITE Applicant (Final Approval) - YELLOW Applicant (Conditional Approval) - PINK