IREDELL COUNTY HEALTH DEPARTMENT - *ENVIRONMENTAL HEALTH* ☒ STATESVILLE OFFICE 704-878-5305 ☐ MOORESVILLE OFFICE 704-664-5281

IMPROVEMENT PERMIT / AUTHORIZATION TO CONSTRUCT / OPERATION PERMIT / EXISTING SYSTEM INSPECTION

PERMIT # 174252 PIN # 4629945497 DATE 10/4/12

OWNER San Thomason APPLICANT: Same PHONE: Home/Cell # 336-971-0380 Business #

SITE ADDRESS 483 Stillwater Rd OWNER / APPLICANT ADDRESS

SITE DIRECTIONS Morrison Farm Road (L) on Day Vault, (R) on Stillwater, .5 miles on left

SUBDIVISION CL & T BLOCK / SECTION 17 LOT # 66 LOT AREA .76 DESIGN FLOW 480 total (120 now) L.T.A.R. .3

Septic Tank EX Gallons: STB 1000 (EX Date

Pump Tank Gallons: P T Date

Pump Make Model Serial #

No. Nitrification Fields: 1 No. Lines 2 Linear Feet (67) 367 total

Trench Width 2 Max. Trench Bottom Depth 36" Gravel Depth n/a

☐ New System ☐ Repair ☒ Expansion System Type I II (III) IV V VI

System Description: 50% Reduction Gravity

Repair System Description: 50% Reduction LP

Maintenance Agreement Required ☐ YES ☒ NO

☒ GRAVITY ☐ PRESSURE

☒ Residence No. Bedrooms (4 total)

☐ Business No. Persons

☐ Other No. Employees


☐ Slab ~~☐~~ Crawl Space

☒ Basement w/plumbing ☐ Basement w/o plumbing

Water Supply: ☒ Private ☐ Public ☐ Community

Comments / Conditions: Install (2) 34' lines of 50% Reduction (PPB PS) (11) tons of sand (16) panels connect to existing system with serial distribution

INITIAL SITE SKETCH

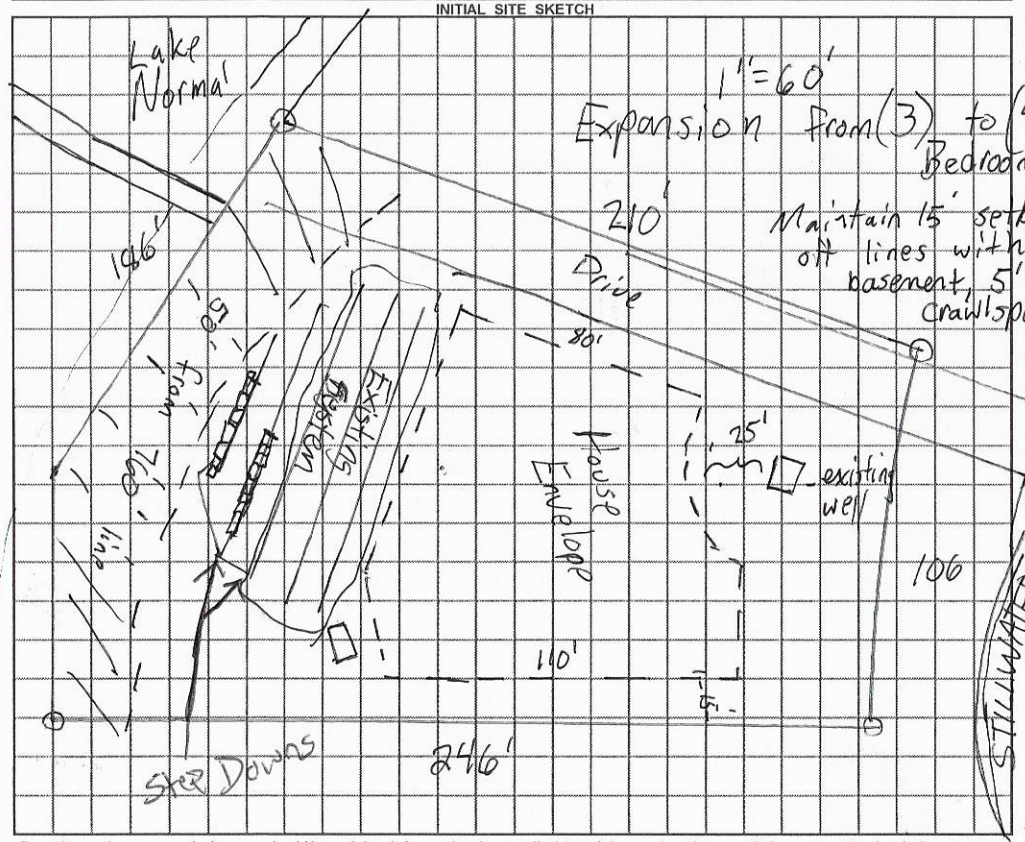

AS BUILT SKETCH

Installed as drawn

Permit can be suspended or revoked if any false information is supplied toward securing the permit / any unauthorized changes are made to the site / any unauthorized changes are made in the installation of the system.

☐ ***IMPROVEMENT PERMIT*** with plat valid without expiration. ☒ ***IMPROVEMENT PERMIT*** with plat valid without expiration. Site plan valid 60 mo. ☒ ***AUTHORIZATION TO CONSTRUCT*** valid for period equal to IMPROVEMENT PERMIT--not to exceed 60 mo.

Owner / Applicant Signature: Date 12-27-12 Installed by: Rowan Septic

IMPROVEMENT PERMIT by: REHS Date 10-15-12 OPERATION PERMIT by: REHS Date 2-20-14

AUTHORIZATION TO CONSTRUCT by: REHS Date 12-27-12 Existing System Inspected by: REHS Date

YOU SHOULD CONTACT A LOCATOR SERVICE PRIOR TO ANY EXCAVATION

White Copy – Environmental Health YELLOW COPY (Final) Owner / Applicant PINK COPY (Initial) Owner / Applicant