IREDELL COUNTY HEALTH DEPARTMENT

STATESVILLE 704-878-5305 MOORESVILLE 704-664-5281

IMPROVEMENT PERMIT / AUTHORIZATION TO CONSTRUCT / OPERATION PERMIT / EXISTING SYSTEM INSPECTION

DATE 01-16-01

PERMIT# 093718 PIN# 4629945497

OWNER OR CONTRACTOR SAMUEL THOMASON PHONE: Business _____ Home 1-336-996-8779

ADDRESS 483 Stillwater Dr Troutman NC 28166

LOCATION DEPOT, L STATE RT, L MORRISON FM, L OAKVALLEY, R STILLWATER

SUBDIVISION _____ BLOCK / SECTION _____ LOT _____ LOT AREA .76 SITE CLASS _____ DESIGN FLOW 360 L.T.A.R. .4

Septic Tank: 1250 Gallons: STB _____ Date _____

Pump Tank: _____ Gallons: PT _____ Date _____

Pump Make: _____ Model _____ Serial No. _____

Nitrification Field: No Fields _____ Square Feet _____ Linear Feet _____

No Lines _____ Trench Width _____ Max Trench Bottom Depth _____ Gravel Depth _____

☐ New System ☐ Repair System Type: I. II. III. IV. V. VI

System Description: EXISTING

Repair System Description: _____

Maintenance Agreement Required. ☐ Yes ☐ No

☐ House/Mod. Home ☒ Mobile Home ☐ Business ☐ Other _____

No. Bedrooms 3 No. Bathrooms 2 No. Employees _____

☐ Slab ☒ Crawl Space ☐ Basement w/plumbing ☐ Basement wo/plumbing


Water Supply: ☒ Individual ☐ Public ☐ Community WELL

Comments/Conditions:

Comments/Conditions:

INITIAL SITE SKETCH

NORMAN AS BUILT SKETCH 3747

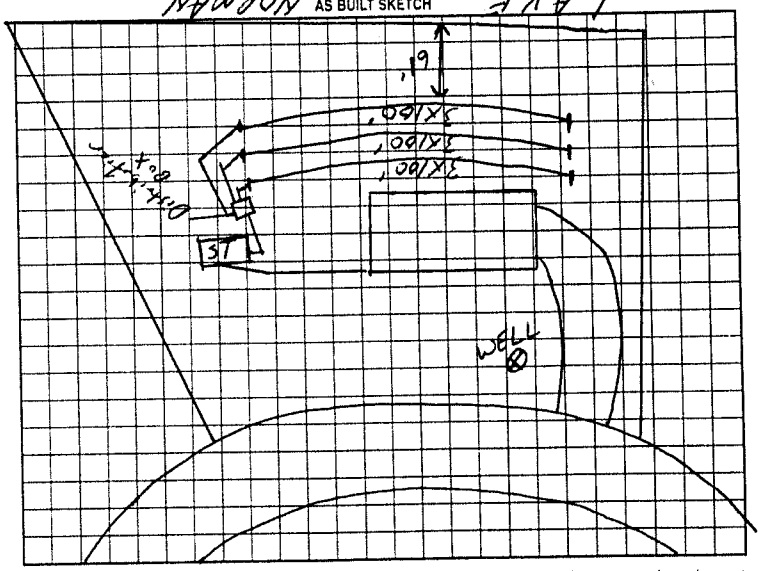

Permit can be suspended or revoked if any false information is supplied toward securing the permit/any unauthorized changes are made to the site/any unauthorized changes are made in the installation of the system. Improvement Permit with plat valid without expiration. Improvement Permit with site plan valid for sixty months. Authorization to Construct is valid for a period equal to that of Improvement Permit – not to exceed sixty months.

Signed: _____ date _____

Improvement Permit by: _____ date _____

Authorization to Construct by: _____ date _____

Installed by: _____

Operation Permit by: _____ date _____

Existing System Inspection by: Steve Cuffe RST date 01-16-01

HEALTH DEPT. COPY: WHITE OWNER COPY (FINAL): YELLOW OWNER COPY (INITIAL): PINK