IREDELL COUNTY HEALTH DEPARTMENT

STATESVILLE 704-878-5305 MOORESVILLE 704-664-5281 48544

IMPROVEMENT PERMIT / CERTIFICATE OF COMPLETION / OPERATION PERMIT / EXISTING SYSTEM INSPECTION

PROPERTY DESCRIPTION NO. 16752 DATE 8-4-93 TAX MAP NO. 3C-2-A-69

OWNER OR CONTRACTOR P.W. Swann PHONE: Business Home 919-768-0236

ADDRESS 2984 Ormond Dr. Winston Salem N.C.

LOCATION Perth Rd TR Duke Power state PKRS TL merrison Fm TL Daywalt cut TR Stillwater 1/4mi on L

SUBDIVISION Lake Norman BLOCK / SECTION 17 LOT 69 LOT AREA .6 acres SITE CLASS L.T.A.R.

Water Supply: ☑ Individual ☐ Community ☐ Public

Septic Tank: 1000 Gallons; STB 1012 Date 10-1-93

Pump Tank: Gallons; PT Date

Nitrification Field: No Fields 2 Square Feet 480 Linear Feet 160

No Lines 2 Trench Width 60 Trench Depth 18 to 76 Gravel Depth 18"

☐ New System ☐ Repair System Type: I (II) III IV V VI

System Description: Addition

Repair System Description:

Maintenance Agreement Required: ☐ Yes ☑ No

☐ House/Mod. Home Total No. Bedrooms 4

☐ Mobile Home No. Bathrooms 3 1/2

☐ Business No. Employees

☐ Other 1500' Addition to Ex House Adding 2 bedrooms

☐ Slab ☐ Crawl Space ☐ Basement w/plumbing ☐ Basement wo/plumbing

Garbage Disposal: ☐ Yes ☑ No


Auto. Dishwasher: ☑ Yes ☐ No

Auto. Washing Machine: ☑ Yes ☐ No


Other

Comments Had to change layout, not enough length to put in 80' bed.

INITIAL SITE SKETCH

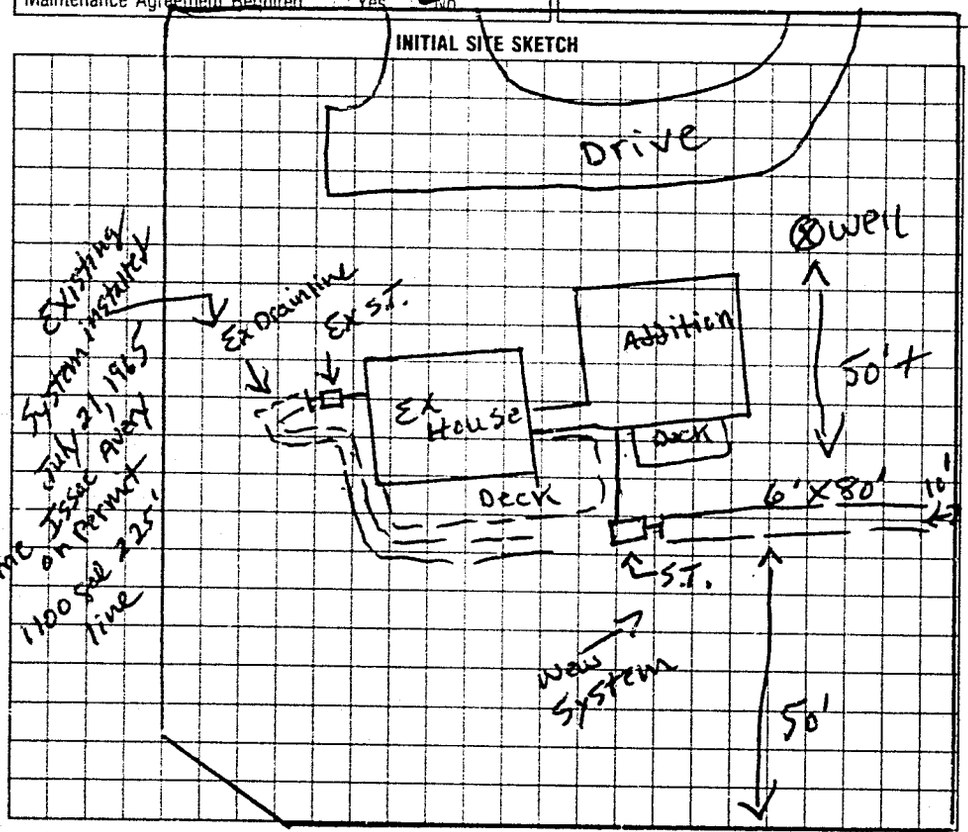

AS BUILT SKETCH

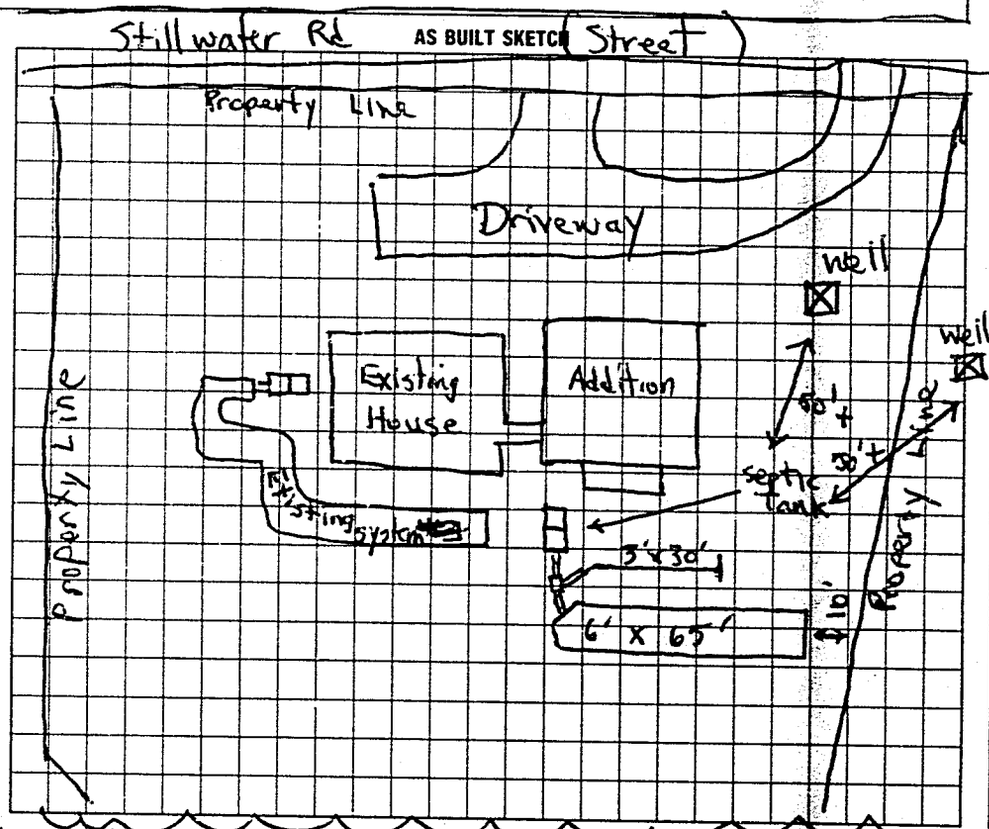

I understand that this permit can be suspended or revoked if any false information is supplied toward securing the permit/any unauthorized changes are made to the site/any unauthorized changes are made in the installation of the system. Improvement Permit is valid for 60 months from date of issuance.

Signed: P.W. Swann

Improvement Permit by: C.C. Moore date 8-4-93

Existing System Inspection by: date

Installed by: Forest Shuford LAKE

Certificate of Completion by: Michael L. Dennis date 3-15-94

Operation Permit by: date

HEALTH DEPT COPY: WHITE INSPECTION COPY (FINAL): GREEN OWNER COPY (FINAL): YELLOW INSPECTION COPY (INITIAL): PINK OWNER COPY (INITIAL): GOLD