23736 55466

IREDELL COUNTY HEALTH DEPARTMENT

STATESVILLE 704-878-5305 MOORESVILLE 704-664-5281

IMPROVEMENT PERMIT / CERTIFICATE OF COMPLETION / OPERATION PERMIT / EXISTING SYSTEM INSPECTION

23736

PROPERTY DESCRIPTION NO. ~~3c-2-A-67~~ DATE 5-15-96 TAX MAP NO. 3c-2-A-67 Watershed: ☐ Yes ☐ No

OWNER OR CONTRACTOR Jean Langston PHONE: Business 910-674-5611 Home

ADDRESS 479 Stillwater Troutman N.C.

LOCATION Perth Ch Rd TR State PR Rd N. morrison Fm Rd TL stillwater at BOX 479

SUBDIVISION Lake Norman BLOCK / SECTION 17 LOT 67 LOT AREA 1/2 acre+ SITE CLASS PS DESIGN FLOW 360 L.T.A.R.

Septic Tank: 1250 Gallons; STB Date

Pump Tank: Gallons; PT Date

Pump Make: Model Serial No.

Nitrification Field: No Fields 1 Square Feet 720 Linear Feet 240

No Lines 2 Trench Width 36" Max Trench Bottom Depth 36" Gravel Depth 12"

☐ New System ☐ Repair System Type: I. II. III. IV. V. VI

System Description:

Repair System Description:

Maintenance Agreement Required: ☐ Yes ☐ No

☐ House/Mod. Home No. Bedrooms 3

☐ Mobile Home No. Bathrooms 2

☐ Business No. Employees

☐ Other

☐ Slab ☐ Crawl Space ☐ Basement w/plumbing ☐ Basement wo/plumbing


Water Supply: ☒ Individual ☐ Community ☐ Public

Comments:

Comments: System Installed under Larry Sigmon Name 10-22-86

INITIAL SITE SKETCH

AS BUILT SKETCH

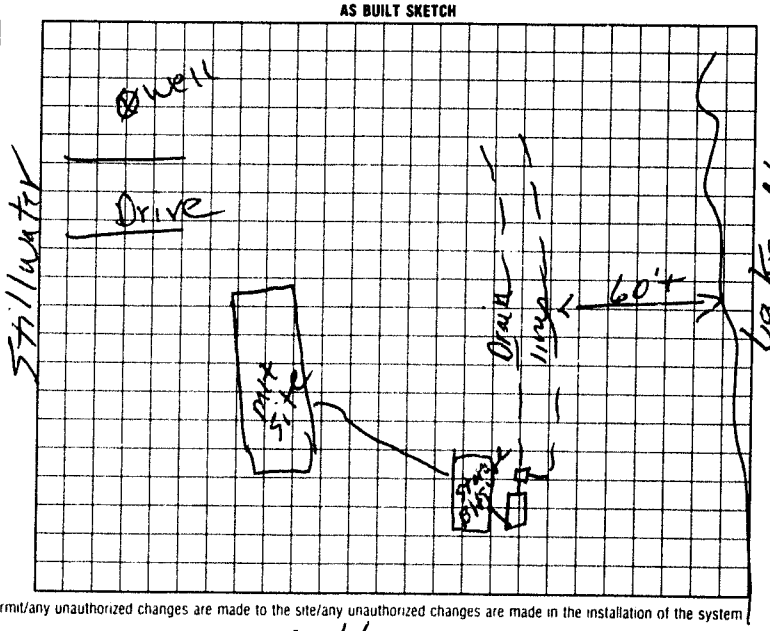

I understand that this permit can be suspended or revoked if any false information is supplied toward securing the permit/any unauthorized changes are made to the site/any unauthorized changes are made in the installation of the system

Signed:

Improvement Permit by: date

Existing System Inspection by: R. C. Moore date 5-15-96

Installed by Wes Lytton

Certificate of Completion by Steve Brown date 10-22-86

Operation Permit by date

HEALTH DEPT. COPY: WHITE INSPECTION COPY (FINAL) GREEN OWNER COPY (FINAL) YELLOW INSPECTION COPY (INITIAL) PINK OWNER COPY (INITIAL) GOLD