3:00

PAID $500.00 1-24-12

IREDELL COUNTY HEALTH DEPARTMENT - *ENVIRONMENTAL HEALTH* ☐ STATESVILLE OFFICE 704-878-5305 ☐ MOORESVILLE OFFICE 704-664-5281

IMPROVEMENT PERMIT / AUTHORIZATION TO CONSTRUCT / OPERATION PERMIT / EXISTING SYSTEM INSPECTION

PERMIT # EXPANSION PIN # 4629-94-6744 DATE FEBRUARY 14, 2012

OWNER THOMAS C. COYLE APPLICANT: PHONE: Home/Cell # 704-340-4844 Business # 704-393-4308

SITE ADDRESS 477 STILLWATER ROAD OWNER / APPLICANT ADDRESS 352 S. LAUREL AVE

SITE DIRECTIONS STATE PARK RD, TO MORRISON FARM RD, TL STILLWATER ROAD, HOUSE ON LEFT AT BOX #477

SUBDIVISION CL & T BLOCK / SECTION 17 LOT # 68 LOT AREA 1.13 ACRES DESIGN FLOW 480 L.T.A.R. EXISTING

Septic Tank EXISTING Gallons: STB ____ Date ____

Pump Tank ____ Gallons: P.T. ____ Date ____

Pump Make ____ Model ____ Serial # ____

No. Nitrification Fields: 1 No. Lines EX (4) Linear Feet EXISTING

Trench Width EX. Max. Trench Bottom Depth 10 EX WELL Gravel Depth EXISTING

☐ New System ☐ Repair ☑ Expansion System Type I (II) III IV V VI

System Description: CONVENTIONAL, GRAVITY

Repair System Description: 50% REDUCTION, LP DISTRIBUTION

Maintenance Agreement Required ☐ YES ☑ NO

☑ GRAVITY ☐ PRESSURE

☑ Residence No. Bedrooms 4

☐ Business No. Persons ____

☐ Other No. Employees ____


☐ Slab ☐ Crawl Space

☐ Basement w/plumbing ☐ Basement w/o plumbing

Water Supply: ☑ Private ☐ Public WELL ☐ Community

Comments / Conditions ① INSTALL THREE (3) NEW DROP BOXES AS SHOWN TO ACHIEVE SERIAL DISTRIBUTION INTO BOTH SYSTEMS ② PLUG UPPER LINE IN DROP BOX TO DISCONTINUE USING IT TO BE RESERVED FOR REPAIR ONLY BECAUSE OF BUILDING FOUNDATION

INITIAL SITE SKETCH

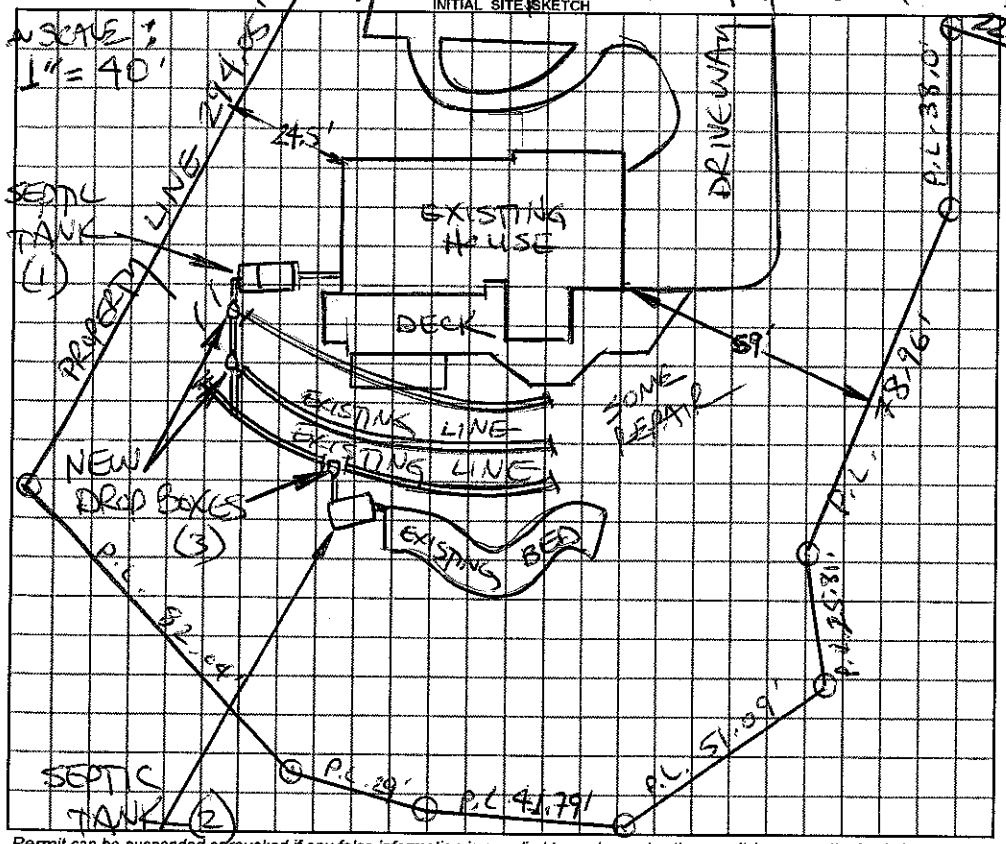

AS BUILT SKETCH

Permit can be suspended or revoked if any false information is supplied toward securing the permit / any unauthorized changes are made to the site / any unauthorized changes are made in the installation of the system.

☐ *IMPROVEMENT PERMIT with plat valid without expiration.* ☑ *IMPROVEMENT PERMIT with ~~plat valid without expiration.~~ site plan valid 60 mo.* ☑ *AUTHORIZATION TO CONSTRUCT* valid for period equal to IMPROVEMENT PERMIT--not to exceed 60 mo.

Owner / Applicant Signature: [signature] Date 2-23-12 Installed by: A-1 Backhoe

IMPROVEMENT PERMIT by: R. STEVE HENDRICK REHS Date 2-14-2012 OPERATION PERMIT by: [signature] REHS Date 5-22-2012

AUTHORIZATION TO CONSTRUCT by: R. STEVE HENDRICK REHS Date 2-14-2012 Existing System Inspected by: ____ REHS Date ____

YOU SHOULD CONTACT A LOCATOR SERVICE PRIOR TO ANY EXCAVATION

White Copy – Environmental Health YELLOW COPY (Final) Owner / Applicant PINK COPY (Initial) Owner / Applicant