IREDELL COUNTY HEALTH DEPARTMENT

Statesville Phone TR 3-7271 Mooresville Phone NO 3-1271

PERMIT TO INSTALL SEPTIC TANK

Permit NO. 391 Permit Date June 3 1971

Owner Howard Knuth Address Statesville

Installed By Lackey Bro Address Stoney Point N.C.

Location of Property Lake Norman


Section 17 - Lot 68

Tank		Capacity		Length of Lines		Fixtures	
Block	( )	1000	(✓)	225'	(✓)	No. of Baths	( )
Precast	(✓)	1250	( )	250'	( )	Dishwasher	( )
		1500	( )	Other		Garbage Grdr.	( )
		Other				Other	

NOTIFY HEALTH DEPARTMENT AT LEAST EIGHT HOURS BEFORE TANK IS TO BE INSPECTED.

Final Inspection June 4 1971 Approved (✓) Disapproved ( )

Remarks

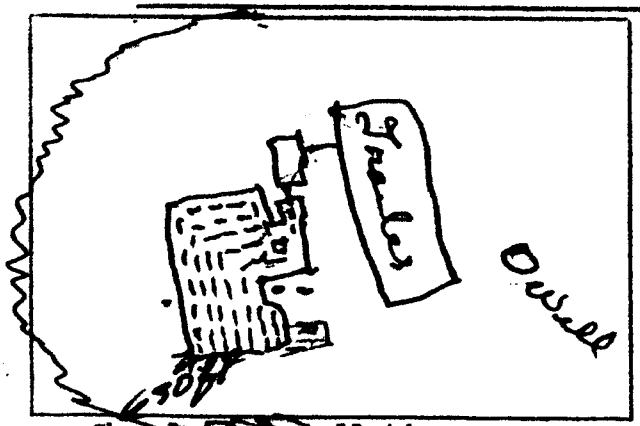

Sketch of Installation

Sanitarian