# IREDELL COUNTY HEALTH DEPARTMENT *ENVIRONMENTAL HEALTH DIVISION*:

## *SITE PLAN WORKSHEET*

**SEE THE "SAMPLE SITE PLAN" BELOW.** ***INCOMPLETE SITE PLANS WILL BE RETURNED TO YOU FOR COMPLETION AND MAY RESULT IN A DELAY IN THE ISSUANCE OF YOUR SEPTIC SYSTEM PERMIT!!!***

**Place an (X) beside each item as you complete the site plan:**

X **Property Line measurements are clearly identified...** X **All proposed structures are indicated...**

***SHOW: proposed house or business footprint, wells, water lines, patios, pools and decks, and any other item that will occupy space on the site***


X **Front and side setbacks from property line...** X **Preferred driveway location and configuration, preferred well location...**

X **Area you prefer your septic system to be placed...** X **North arrow, or other sufficient indicator of direction...**

**Circle N/A on the following if appropriate:**

__ __ **Location of septic systems and wells within 100' of your property...** (N/A)

____ **Location of easements and rights of ways on your property...** (N/A) __ __ **Location of any designated wetlands on the property...** (N/A)

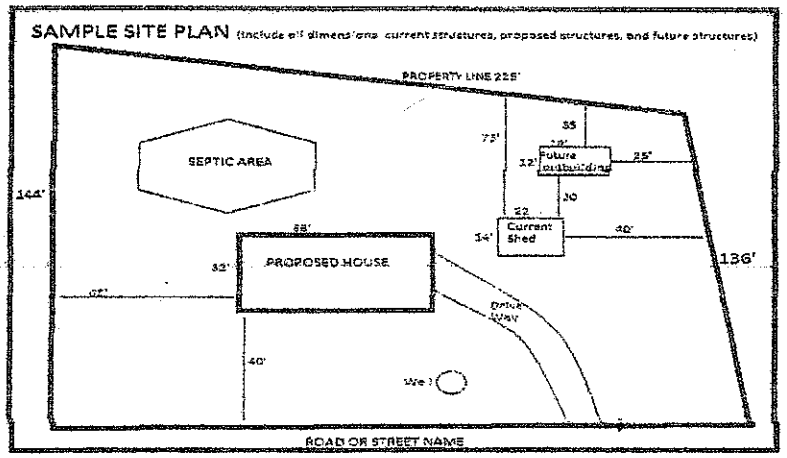


**USE THIS SPACE TO DRAW YOUR SITE PLAN**


Please see attached site plan

**Signature:** Emma Hall

*REQUIRED* property owner or owner's legal representative signature.

7/7/2016

DATE

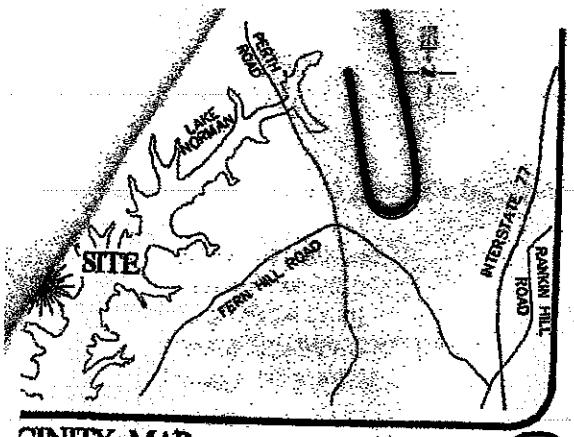


CINITY MAP
ot To Scale

3. SETBACKS/ EASEMENTS SHOULD BE VERIFIED WITH DEVELOPER AND LOCAL OFFICIALS PRIOR TO CONSTRUCTION.
4. THIS IS A CONCEPTUAL DRAWING AND CONTENTS SHOWN HEREON ARE SUBJECT TO CHANGE UPON FINAL CONSTRUCTION.

As built

APPROVED JUL 2 2 2016

16
FALL'S PARK
PHASE 2
BK 62 PG 2

17
FALL'S PARK
PHASE 2
BK 62 PG 2

12
FALL'S PARK
PHASE 2
BK 62 PG 2

10

11

N72°47'01"W
137.23'

1"=50'

MB. 63 PG. 38

25' REAR YARD

10' SETBACK

10' SETBACK

43,669 Sq Ft±
1.00 Ac.±

97' REPAIR R
120' REPAIR O
134' REPAIR E
134' REPAIR O
134' REPAIR P

S31°35'29"W
285.93'

N31°44'12"E
268.63'

26'
pool
20'

#446

Gas line

39.0'

Duke Power line

NF 16
B-92'
P-100'
O-103'
B-112'
O-109'
P-68'

Drive

25' SETBACK

C1

STILLWATER

60' PUB

17.1
8.0
DECK
12.8
3.0
19.0
13.3
51.0
PROVIDENCE II
3237 "R"
2-CAR
GAR LEFT
CRAWL
W/ BRICK
1/8/10
SCALE: 1";30'
21.0
11.9
1.0
5.8
0
12.3
8.0
20.7

Actual
NF - 16
B - 92
P - 100
O - 103
B - 112
O - 109
P - 68