IREDELL COUNTY HEALTH DEPARTMENT

STATESVILLE 704-878-5305 (51) MOORESVILLE 704-664-5281

IMPROVEMENT PERMIT / AUTHORIZATION TO CONSTRUCT / OPERATION PERMIT / EXISTING SYSTEM INSPECTION

(C) (L)

PERMIT# 114489 PIN# 4629-95-1574 DATE 8-15-03

OWNER OR CONTRACTOR JAMES A. BRANSCOMB PHONE: Business 704-528-6558 Home 336-767-1694

ADDRESS 5559 OVERLOOK CIR, WINSTON-SALEM, NC 27105

LOCATION US21 S TR PERTH, TR ~~MORRIS STATE PARK~~, TL MORRISON FARM, TL DAYVAULT, TR STILLWATER, 0.25 MI. ON


SUBDIVISION CRESCENT BLOCK / SECTION 17 LOT 74 LOT AREA 0.71 ACRE SITE CLASS. PS DESIGN FLOW 360 L.T.A.R. 0.30 GPD/FT²

Septic Tank: 1000 Gallons; STB 11-17-03 Date 10-17	☑ New System ☐ Repair System Type: I, II, III, IV, V	☑ House/Mod. Home No. Bedrooms 3	Water Supply: ☑ Individual
Pump Tank: 1000 Gallons; PT 10-17-03 Date 17	System Description: 50% REDUCTION, PUMP	☐ Mobile Home No. Bathrooms 2	☐ Public ☐ Community
Pump Make: GOULDS Model WE0511H Serial No. C04652776	Repair System Description: MAX. FEAS. (1945)	☐ Business No. Employees ___	WELL
Nitrification Field: No. Fields 1 Square Feet 1200 Linear Feet 200	Maintenance Agreement Required: ☐ Yes ☑ No	☐ Other ___	
No Lines ~~FOUR~~ FIVE Trench Width 24" Max Trench Bottom Depth 36" ~~Gravel~~ Depth SAND 24"		☐ Slab ☑ Crawl Space ☐ Basement w/plumbing ☐ Basement wo/plumbing	


Comments:/Conditions: (3) KEEP SYSTEM MINIMUM 5' FROM PROPERTY LINE, 50' FROM WELLS (1951) (2) INSTALL 48 PPBPS PANELS ON CONTOUR (3) SEE ATTACHED SHEETS FOR PUMP & PRESSURE MANIFOLD REQUIREMENTS

Comments:/Conditions: SYSTEM CHANGED TO FIVE 40' LINES AS SHOWN WITH PRIOR HEALTH DEPT. (45 PPBPS PANELS). FUTURE REPAIR WILL REQUIRE RELOCATING & ABANDONING EXISTING WELL

INITIAL SITE SKETCH

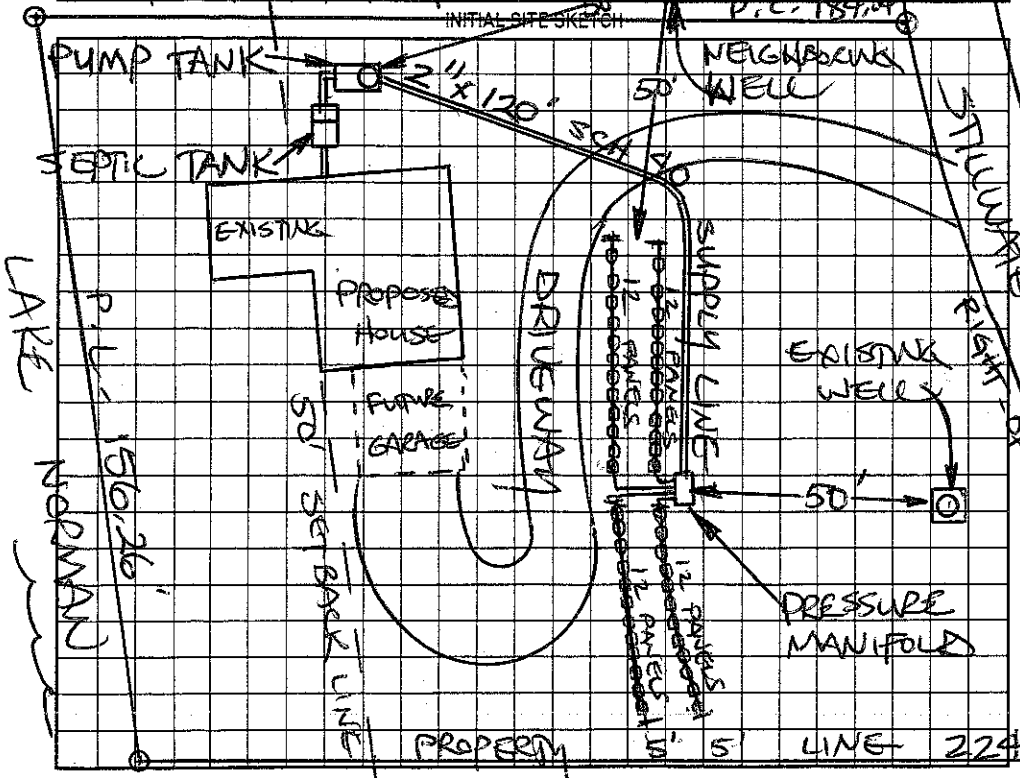

AS BUILT SKETCH

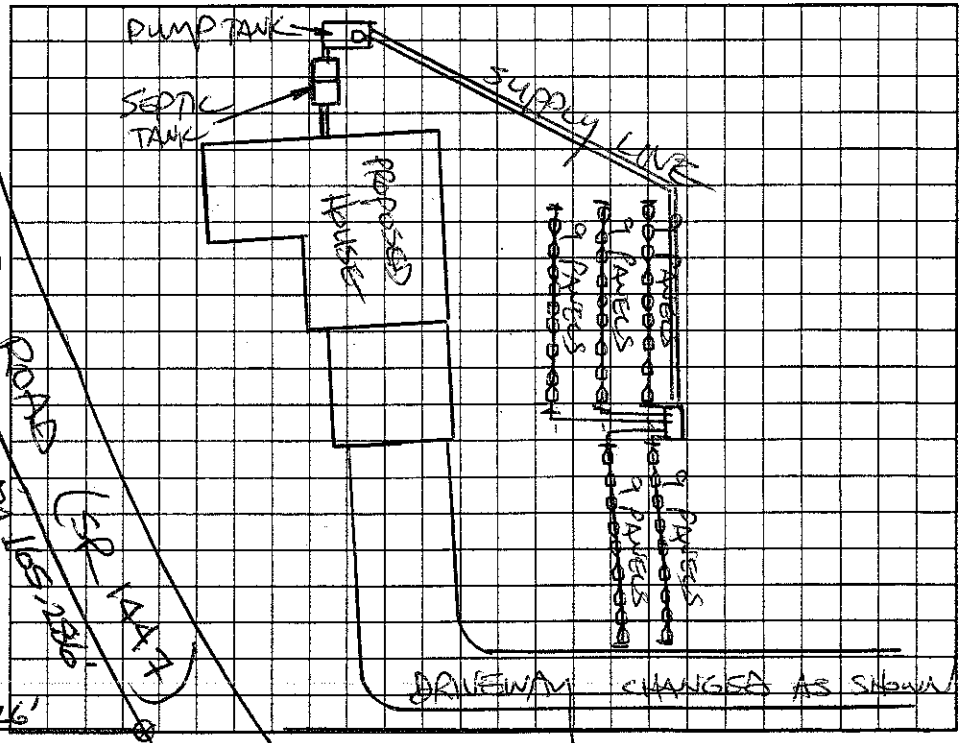

Permit can be suspended or revoked if any false information is supplied toward securing the permit/any unauthorized changes are made to the site/any unauthorized changes are made in the installation of the system. Improvement Permit with plat valid without expiration. Improvement Permit with site plan valid for sixty months. Authorization to Construct is valid for a period equal to that of Improvement Permit – not to exceed sixty months.

Signed: James Branscomb date 8-15-03 Installed by: PIEDMONT BACKHOE

Improvement Permit by: STEVE HEDRICK date 8-15-03 Operation Permit by: STEVE HEDRICK date 5-21-04

Authorization to Construct by: STEVE HEDRICK date 8-15-03 Existing System Inspection by: ___ date ___

HEALTH DEPT. COPY: WHITE OWNER COPY (FINAL): YELLOW OWNER COPY (INITIAL): PINK