IREDELL COUNTY HEALTH DEPARTMENT

Statesville Phone TR 3-7271 Mooresville Phone NO 3-1271

PERMIT TO INSTALL SEPTIC TANK

Permit NO. 191 Permit Date June 10 1970

Owner William Warlick Address Statesville, NC

Installed By Adams Septic Tank Serv Address Taylorsville, NC.

Location of Property Fifth Church Road to Road #1321


Section 17 - Lot 70 Lake Norman

Tank		Capacity		Length of Lines		Fixtures	
Block	( )	1000	(✓)	225'	(✓)	No. of Baths	(1)
Precast	(✓)	1250	( )	250'	( )	Dishwasher	( )
		1500	( )	Other		Garbage Grdr.	( )
		Other				Other	

NOTIFY HEALTH DEPARTMENT AT LEAST EIGHT HOURS BEFORE TANK IS TO BE INSPECTED.

Final Inspection June 10 1970 Approved (✓) Disapproved ( )

Remarks Well on Lot South of House.

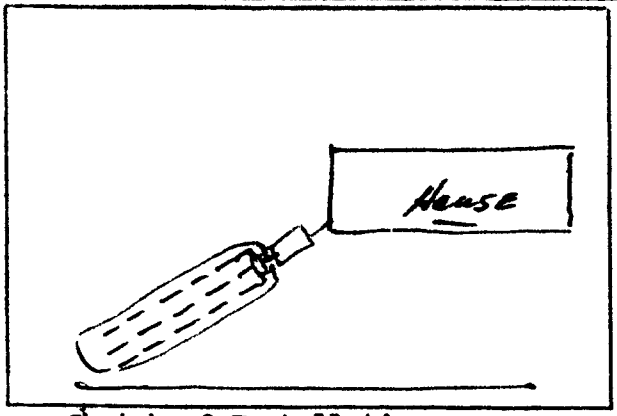

Sketch of Installation

Glenn Ford

Sanitarian