IREDELL COUNTY HEALTH DEPARTMENT

STATESVILLE 704-878-5305 MOORESVILLE 704-664-5281

IMPROVEMENT PERMIT / AUTHORIZATION TO CONSTRUCT / OPERATION PERMIT / EXISTING SYSTEM INSPECTION

PERMIT# 107219 PIN# 4629-96-3522 DATE 8/21/02

OWNER OR CONTRACTOR Ronnie Campbell PHONE: Business Home 704-732-0284

ADDRESS 415 E. Sumner St. Lincolnton NC 28092

LOCATION Perth, TR State Park Rd, TL Morrison Farm, TL Stillwater, on Lt.

SUBDIVISION CL+T BLOCK / SECTION 18 LOT 895 LOT AREA SITE CLASS PS DESIGN FLOW 240 L.T.A.R.

Septic Tank: Existing Gallons: STB Date

Pump Tank: Gallons: PT Date

Pump Make: Model Serial No.

Nitrification Field: No Fields Square Feet Linear Feet 240'

No. Lines 3 @ 80' Trench Width Max Trench Bottom Depth Gravel Depth

☐ New System ☐ Repair System Type I II III IV V VI

System Description: Existing Conventional

Repair System Description:

Maintenance Agreement Required: ☐ Yes ☒ No

☒ House/Mod Home No. Bedrooms 2

☐ Mobile Home No. Bathrooms 1

☐ Business No. Employees

☐ Other

☐ Slab ☒ Crawl Space ☐ Basement w/plumbing ☐ Basement wo/plumbing

Water Supply: ☒ Individual ☐ Public ☐ Community Existing


Comments/Conditions:

Comments/Conditions

Stillwater

INITIAL SITE SKETCH

AS BUILT SKETCH

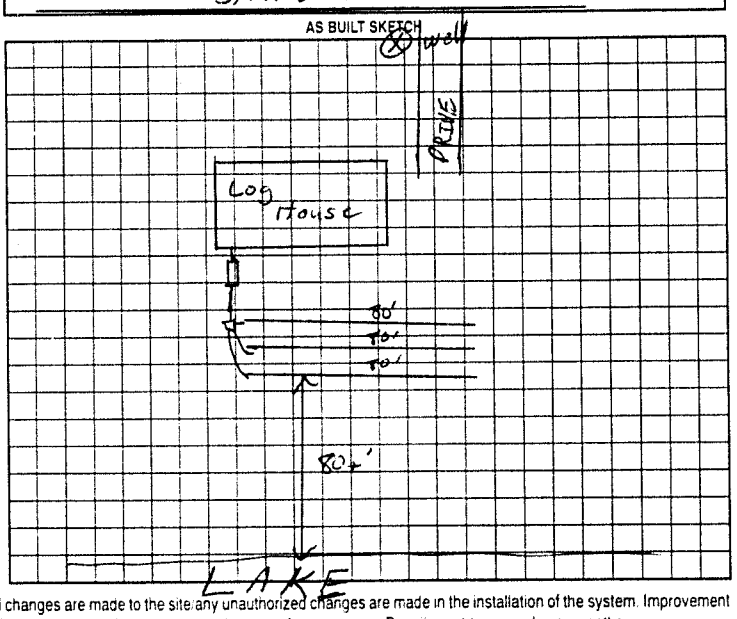

Permit can be suspended or revoked if any false information is supplied toward securing the permit/any unauthorized changes are made to the site/any unauthorized changes are made in the installation of the system. Improvement Permit with plat valid without expiration. Improvement Permit with site plan valid for sixty months. Authorization to Construct is valid for a period equal to that of Improvement Permit – not to exceed sixty months.

Signed: [signature] date 8/26/02 Installed by:

Improvement Permit by: date Operation Permit by: date

Authorization to Construct by: date Existing System Inspection by: [signature] RS date 8/21/02

HEALTH DEPT COPY WHITE OWNER COPY (FINAL) YELLOW OWNER COPY (INITIAL) PINK