Ronnie Campbell Permit # 202787

IREDELL COUNTY HEALTH DEPARTMENT - *ENVIRONMENTAL HEALTH* ☐ STATESVILLE OFFICE 704-878-5305 ☐ MOORESVILLE OFFICE 704-664-5281

IMPROVEMENT PERMIT / AUTHORIZATION TO CONSTRUCT / OPERATION PERMIT / EXISTING SYSTEM INSPECTION

PERMIT # 170524 PIN # 4629-96-3522 DATE FEBRUARY 15, 2012

OWNER RONNIE CAMPBELL APPLICANT: SAME PHONE: Home/Cell # 704-400-0186 Business # 704-732-0284

SITE ADDRESS 293 STILLWATER ROAD OWNER / APPLICANT ADDRESS

SITE DIRECTIONS STATE PARK ROAD TO MORRISON FARM RD, TL STILLWATER RD, ON LEFT AT BOX # 293

SUBDIVISION CL & T BLOCK / SECTION 18 LOT # 895 LOT AREA DESIGN FLOW 240 L.T.A.R. EXISTING

Septic Tank 1000 Gallons: STS Date
Pump Tank Gallons: P T Date
Pump Make Model Serial #
No. Nitrification Fields: 1 No. Lines 3 Linear Feet 240
Trench Width 36" Max. Trench Bottom Depth EX Gravel Depth 12"


☐ New System ☐ Repair ☐ Expansion System Type I (II) III IV V VI
System Description: CONVENTIONAL, GRAVITY
Repair System Description:
Maintenance Agreement Required ☐ YES ☒ NO
☒ GRAVITY ☐ PRESSURE

☒ Residence No. Bedrooms 2
☐ Business No. Persons
☐ Other No. Employees
☐ Slab ☒ Crawl Space
☐ Basement w/plumbing ☐ Basement w/o plumbing

Water Supply: ☒ Private WELL ☐ Public ☐ Community

Comments / Conditions


INITIAL SITE SKETCH

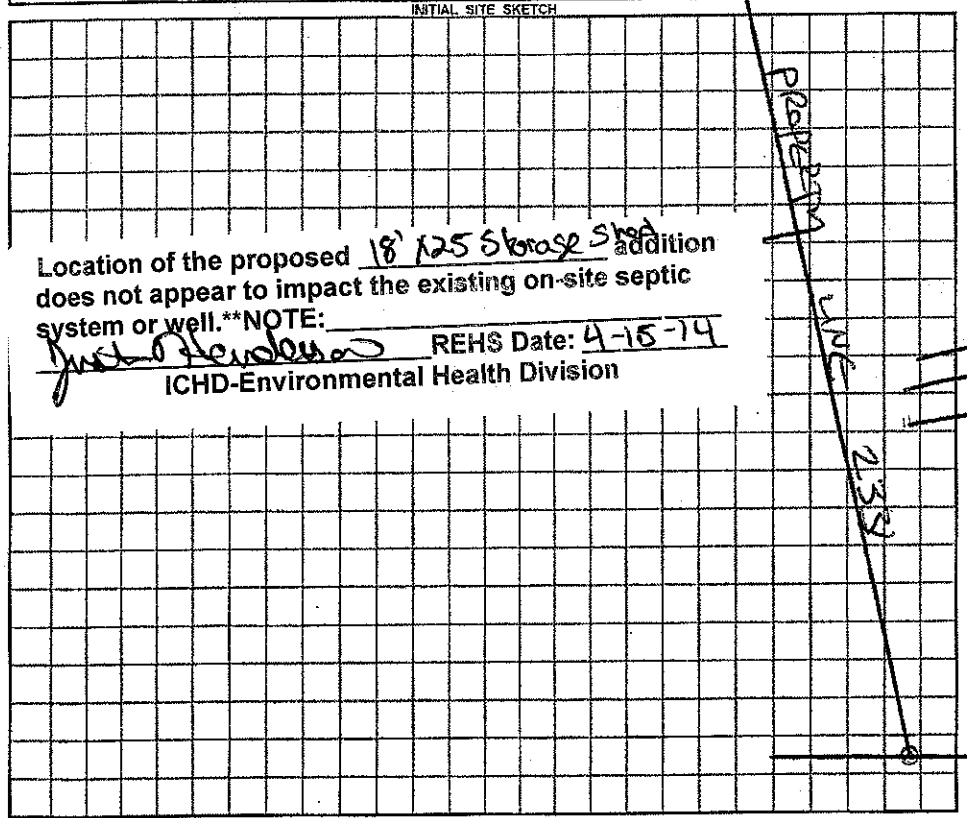

Location of the proposed 18' X 25' Storage Shed addition does not appear to impact the existing on-site septic system or well.**NOTE:

ICHD-Environmental Health Division

AS BUILT SKETCH

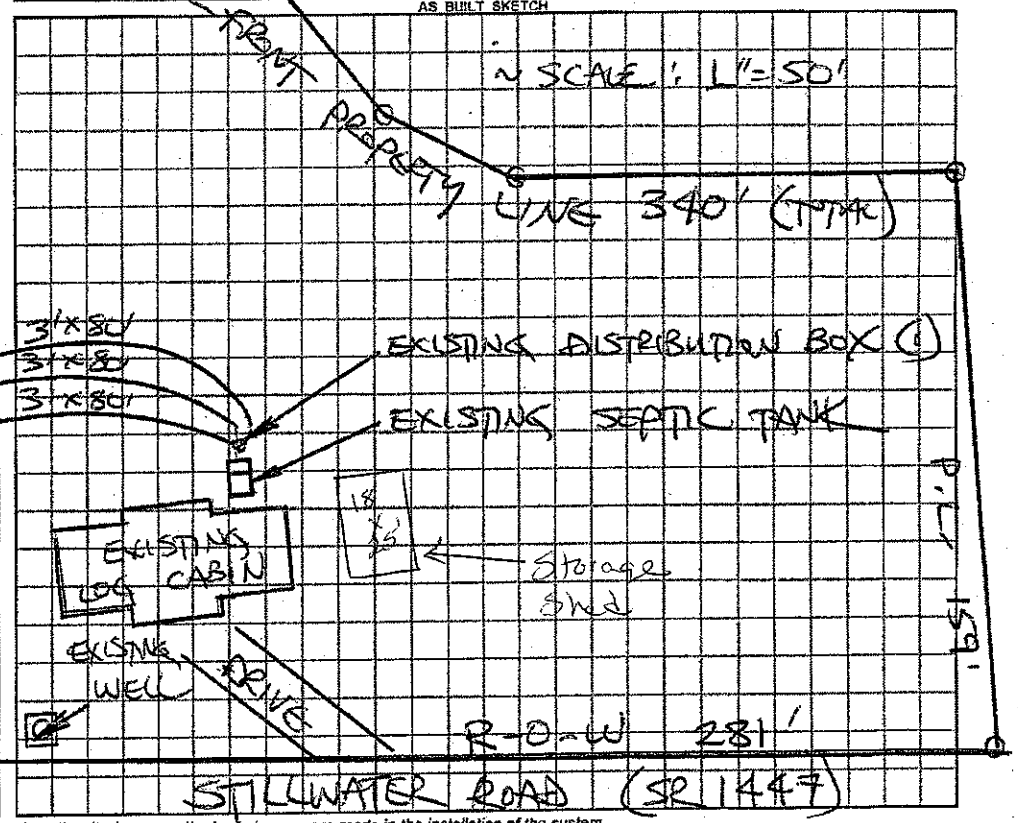

Permit can be suspended or revoked if any false information is supplied toward securing the permit / any unauthorized changes are made to the site / any unauthorized changes are made in the installation of the system.

☐ *IMPROVEMENT PERMIT with plat valid without expiration.* ☐ *IMPROVEMENT PERMIT with plat ~~valid without expiration~~ site plan valid 60 mo.* ☐ *AUTHORIZATION TO CONSTRUCT* valid for period equal to IMPROVEMENT PERMIT--not to exceed 60 mo.

Owner / Applicant Signature: Date Installed by:

IMPROVEMENT PERMIT by: REHS Date OPERATION PERMIT by: REHS Date

AUTHORIZATION TO CONSTRUCT by: REHS Date Existing System Inspected by: STEVE HENDRICK REHS Date 2-15-12

YOU SHOULD CONTACT A LOCATOR SERVICE PRIOR TO ANY EXCAVATION

White Copy – Environmental Health YELLOW COPY (Final) Owner / Applicant PINK COPY (Initial) Owner / Applicant