IREDELL COUNTY HEALTH DEPARTMENT

STATESVILLE 704-878-5305 MOORESVILLE 704-664-5281

IMPROVEMENT PERMIT / AUTHORIZATION TO CONSTRUCT / OPERATION PERMIT / EXISTING SYSTEM INSPECTION

PERMIT# REPAIR PIN# 4629 96 4312 DATE 7-26-02

OWNER OR CONTRACTOR WILLIAM GREGORY PAYNE PHONE: Business 704-872-5231 Home

ADDRESS 287 STILLWATER ROAD TROUTMAN, NC 28166-9802

LOCATION STATE PARK RD TR MORRISON FARM RD, TL DAIRY VAULT CUT, TR STILLWATER RD, ON RIGHT AT #287

SUBDIVISION DUKE BLOCK / SECTION 18 LOT 5 LOT AREA AMPLE SITE CLASS PS DESIGN FLOW 360 L.T.A.R. EXISTING

Septic Tank: 1000 EXISTING Gallons: STB Date

Pump Tank: Gallons: PT Date

Pump Make: Model Serial No.

Nitrification Field: No Fields 1 Square Feet 300 Linear Feet 100

No Lines ONE Trench Width 36" Max Trench Bottom Depth 36" Gravel Depth 12"

~~New System~~ ☐ Repair System Type: I (II) III, IV, V, VI

System Description:

Repair System Description: CONVENTIONAL, GRAVITY

Maintenance Agreement Required: ☐ Yes ☒ No

☐ Slab ☐ Crawl Space ☐ Basement w/plumbing ☐ Basement wo/plumbing

☐ House/Mod. Home No. Bedrooms 3

☒ Mobile Home No. Bathrooms 2

☐ Business No. Employees


☐ Other

Water Supply: ☒ Individual ☐ Public ☐ Community

Comments/Conditions: ① INSTALL NEW DISTRIBUTION BOX AT LOCATION SHOWN PUMPING OLD LINE FIRST ② THIS PERMIT SERVES AS "NOTICE OF VIOLATION" SYSTEM TO BE REPAIRED BY 8-26-2002

Comments/Conditions:

INITIAL SITE SKETCH

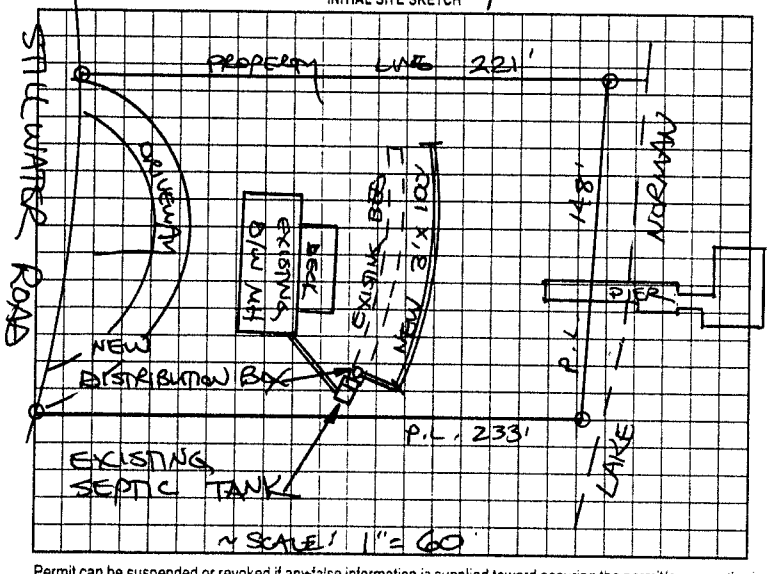

AS BUILT SKETCH

SYSTEM REPAIRED ACCORDING TO INITIAL SITE SKETCH

Permit can be suspended or revoked if any false information is supplied toward securing the permit/any unauthorized changes are made to the site/any unauthorized changes are made in the installation of the system. Improvement Permit with plat valid without expiration. Improvement Permit with site plan valid for sixty months. Authorization to Construct is valid for a period equal to that of Improvement Permit – not to exceed sixty months.

Signed: X William Payne date 7-26-02 Installed by: JAMES HUNTER

Improvement Permit by: STEVE HEDRICK date 7-26-02 Operation Permit by: STEVE HEDRICK date 8-6-02

Authorization to Construct by: STEVE HEDRICK date 7-26-02 Existing System Inspection by: date

HEALTH DEPT. COPY: WHITE OWNER COPY (FINAL): YELLOW OWNER COPY (INITIAL): PINK