IREDELL COUNTY HEALTH DEPARTMENT

STATESVILLE 704-878-5305 MOORESVILLE 704-664-5281

IMPROVEMENT PERMIT / AUTHORIZATION TO CONSTRUCT / OPERATION PERMIT / EXISTING SYSTEM INSPECTION

PERMIT# 121858 PIN# 4629-96-5744 DATE 6-29-04

OWNER OR CONTRACTOR ROBERT YOURZMAN PHONE: Business 704-450-3076 Home 410-721-1659

ADDRESS 2459 NANTUCKET DR CROFTON, MD 21114

LOCATION PERTH RD SOUTH (R) STATE PARK (L) MORRISON FARM (L) Stillwater around dog leg w/ vac lot on rt

SUBDIVISION Stillwater EST BLOCK / SECTION LOT 6 LOT AREA 1.76 AC SITE CLASS. PS DESIGN FLOW 360 L.T.A.R. .3

Septic Tank: 1000 Gallons; STB 760 Date 7-16-10

Pump Tank: 1000 Gallons; PT 363 Date 2-21-10

Pump Make: Model Serial No.

Nitrification Field: No Fields 1 Square Feet EB=1200 Linear Feet 300'

No Lines 5x60' Trench Width 36" Max Trench Bottom Depth 24" Gravel Depth N/A

☒ New System ☐ Repair System Type: I, II, (III) IV, V, VI

System Description: PUMP 2501b DED

Repair System Description: LP PAVER

Maintenance Agreement Required: ☐ Yes ☒ No

☒ House/Mod. Home No. Bedrooms 3

☐ Mobile Home No. Bathrooms 2

☐ Business No. Employees

☐ Other


☐ Slab ☒ Crawl Space ☐ Basement w/plumbing ☐ Basement wo/plumbing

Water Supply: ☑ Individual ☐ Public ☐ Community


Comments/Conditions: (1) FILL & PAVE WALKOUT & STAY 5' OFF (2) NOTE MAXIMUM TRENCH BOTTOM DEPTH (3) INSTALL LINES ON CONTOURS & MAINTAIN SETBACKS

Comments/Conditions: (4) CALL PRIDE TO [redacted] INSTALLATION FOR PUMP SIZING & SPECS IF NECESSARY.

INITIAL SITE SKETCH

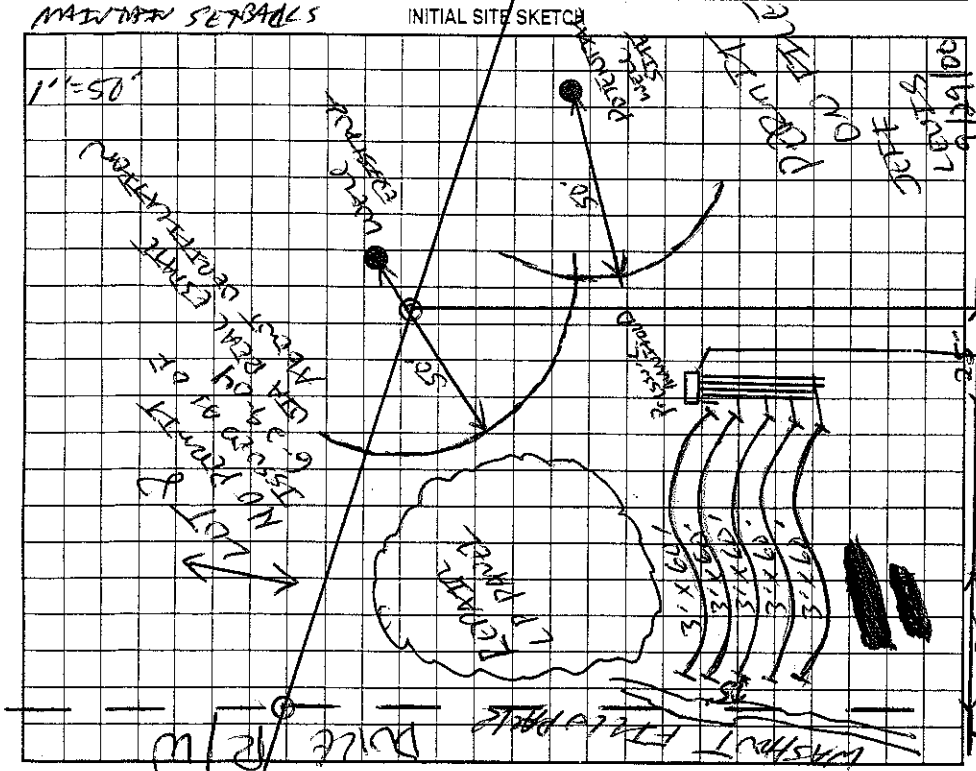

AS BUILT SKETCH

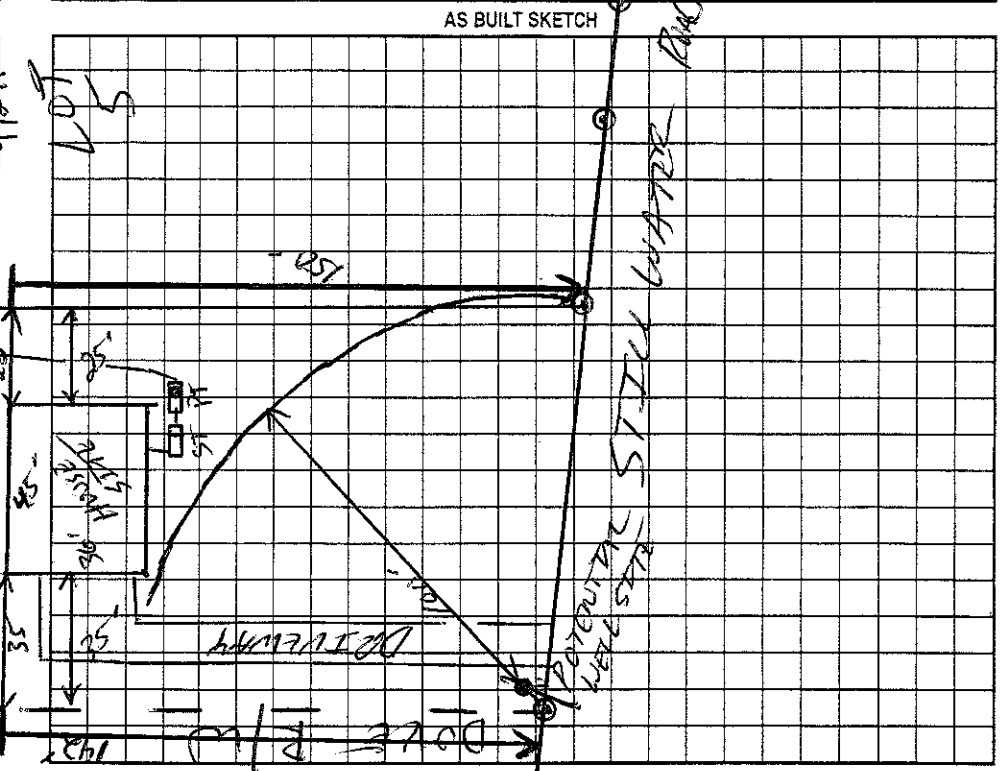

Permit can be suspended or revoked if any false information is supplied toward securing the permit/any unauthorized changes are made to the site/any unauthorized changes are made in the installation of the system. Improvement Permit with plat valid without expiration. Improvement Permit with site plan valid for sixty months. Authorization to Construct is valid for a period equal to that of Improvement Permit – not to exceed sixty months.

Signed: Brenda Jordan date 7-1-04 Installed by: Gunter Grading

Improvement Permit by: date 6-29-04 Operation Permit by: date 12-16-10

Authorization to Construct by: date 11-5-10 Existing System Inspection by: date

HEALTH DEPT. COPY: WHITE OWNER COPY (FINAL): YELLOW OWNER COPY (INITIAL): PINK

AK Erin Ward 11/5/10