IREDELL COUNTY HEALTH DEPARTMENT

STATESVILLE 704-878-5305 MOORESVILLE 704-664-5281

IMPROVEMENT PERMIT / AUTHORIZATION TO CONSTRUCT / OPERATION PERMIT / EXISTING SYSTEM INSPECTION

PERMIT# 132721 PIN# 4629968911 DATE 12-1-05

OWNER OR CONTRACTOR Building Spec. PHONE: Business 704-660-343 Home

ADDRESS 162 Freeze Crossing Drive, Mooresville NC 28115

LOCATION State Park RD to Monbsa Farm RD to Shelwater Property on Right

SUBDIVISION Stillwater Est BLOCK / SECTION LOT 7 LOT AREA 1.71 SITE CLASS PS DESIGN FLOW 360 L.T.A.R. .13

Septic Tank: 1000 Gallons; STB 825 Date 3-11-06

Pump Tank: Gallons; PT Date

Pump Make: Model Serial No.

Nitrification Field: No Fields Square Feet 200 Linear Feet 300

No Lines 5 Trench Width 36" Max Trench Bottom Depth 36" Gravel Depth NA

☑ New System ☐ Repair System Type: I II III IV V VI

System Description: 25% Reduction

Repair System Description: 25% Expansion 1 Pad

Maintenance Agreement Required: ☐ Yes ☑ No

☐ House/Mod. Home No. Bedrooms 3

☐ Mobile Home No. Bathrooms

☐ Business No. Employees

☐ Other

☐ Slab ☑ Crawl Space ☐ Basement w/plumbing ☐ Basement wo/plumbing


Water Supply: ☑ Individual ☐ Public ☐ Community

Comments:/Conditions:


Comments:/Conditions:

Install on Contour
Maintain all setbacks
Blue Poly lock
Septic tank marker

INITIAL SITE SKETCH

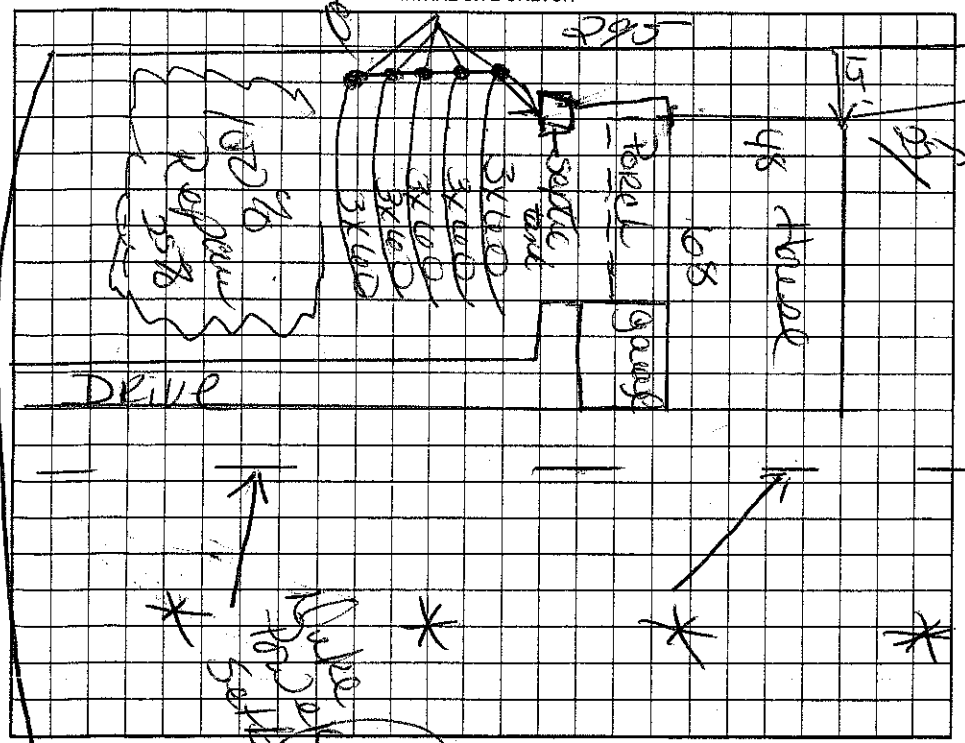

AS BUILT SKETCH

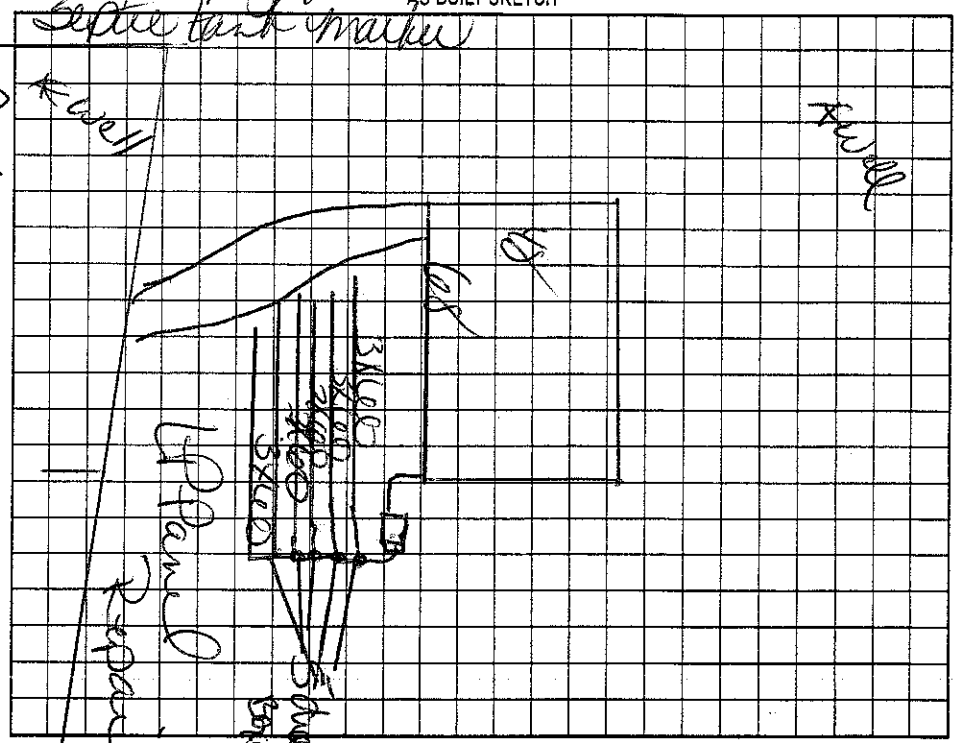

Permit can be suspended or revoked if any false information is supplied toward securing the permit/any unauthorized changes are made to the site/any unauthorized changes are made in the installation of the system. Improvement Permit with plat valid without expiration. Improvement Permit with site plan valid for sixty months. Authorization to Construct is valid for a period equal to that of Improvement Permit – not to exceed sixty months.

Signed: date Installed by: Joe Thompson

Improvement Permit by: Lee Cook date 12-1-05 Operation Permit by: Lee Cook date 5-10-06

Authorization to Construct by: Lee Cook date 12-1-05 Existing System Inspection by: date

HEALTH DEPT. COPY: WHITE OWNER COPY (FINAL): YELLOW OWNER COPY (INITIAL): PINK