IREDELL COUNTY HEALTH DEPARTMENT

STATESVILLE 704-878-5305 MOORESVILLE 704-664-5281

IMPROVEMENT PERMIT / AUTHORIZATION TO CONSTRUCT / OPERATION PERMIT / EXISTING SYSTEM INSPECTION

PERMIT# 90125 PIN# 4639736156 DATE 11/9/00

OWNER OR CONTRACTOR Michael Jacosky PHONE: Business _____ Home _____

ADDRESS 20803 C Sterling Bay Ln. E Cornelius NC 28031

LOCATION State Park Rd / L Morrison Farm, L Stillwater, on Lt in sharp Curve

SUBDIVISION Stillwater BLOCK / SECTION _____ LOT 1 LOT AREA .76 AC SITE CLASS PS DESIGN FLOW 480 L.T.A.R. 0.3

Septic Tank: 1000 Gallons; STB 794 Date 10/16/00
Pump Tank: _____ Gallons; PT _____ Date _____
Pump Make: _____ Model _____ Serial No. _____
Nitrification Field: No Fields 1 Square Feet 1600 Linear Feet 534
No Lines 4@134 Trench Width 36" Max Trench Bottom Depth 56" Gravel Depth 12"

[X] New System [ ] Repair System Type: I, II, III, IV, V, VI
System Description: Gravity Conv.
Repair System Description: Gravity 25% Red.
Maintenance Agreement Required: [ ] Yes [X] No
[ ] Slab [X] Crawl Space [ ] Basement w/plumbing [ ] Basement wo/plumbing


[X] House/Mod. Home No. Bedrooms 4
[ ] Mobile Home No. Bathrooms 3.5
[ ] Business No. Employees _____
[ ] Other _____

Water Supply: [X] Individual [ ] Public [ ] Community


Comments:/Conditions:

Comments:/Conditions: Filter Installed

INITIAL SITE SKETCH

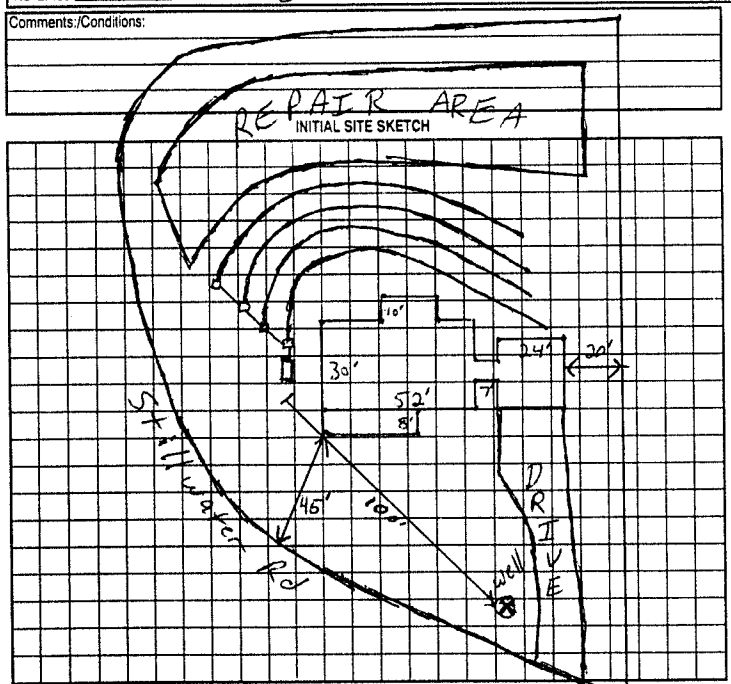

AS BUILT SKETCH

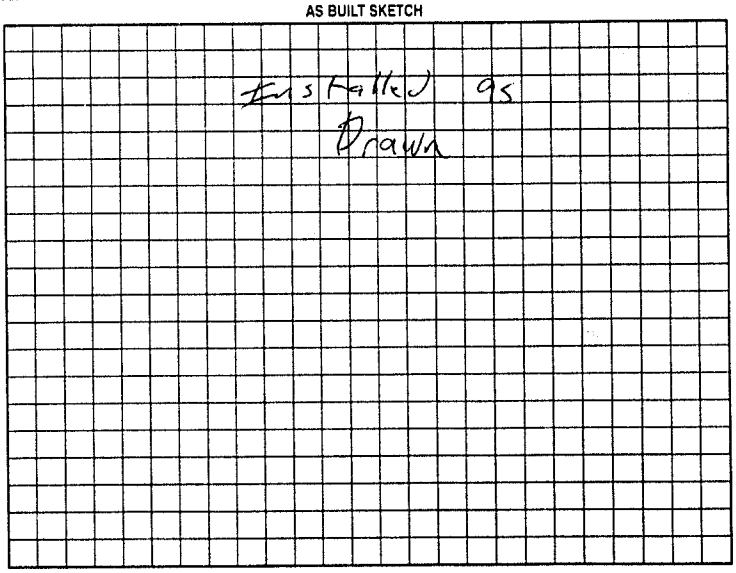

Permit can be suspended or revoked if any false information is supplied toward securing the permit/any unauthorized changes are made to the site/any unauthorized changes are made in the installation of the system. Improvement Permit with plat valid without expiration. Improvement Permit with site plan valid for sixty months. Authorization to Construct is valid for a period equal to that of Improvement Permit – not to exceed sixty months.

Signed: _____ date 11/13/00

Improvement Permit by: RSI date 11/9/00

Authorization to Construct by: RSI date 11/9/00

Installed by: Craig Thompson

Operation Permit by: RSI date 12/29/00

Existing System Inspection by: _____ date _____

HEALTH DEPT. COPY: WHITE OWNER COPY (FINAL): YELLOW OWNER COPY (INITIAL): PINK