IREDELL COUNTY HEALTH DEPARTMENT

STATESVILLE 704-878-5305 MOORESVILLE 704-664-5281

IMPROVEMENT PERMIT / AUTHORIZATION TO CONSTRUCT / OPERATION PERMIT / EXISTING SYSTEM INSPECTION

PERMIT# 91687 PIN# 4639761566 PT DATE 9/11/00

OWNER OR CONTRACTOR CPR INC. PHONE: Business (704) 825-1000 Home

ADDRESS PO Box 126 Belmont NC 28012

LOCATION St Park L Morrison Farm, L Stillwater on Rt

SUBDIVISION Stillwater EST BLOCK / SECTION — LOT 2 LOT AREA .84 AC SITE CLASS PS DESIGN FLOW 480 L.T.A.R. 0.3

Septic Tank: 1000 Gallons; STB 1012 Date 8-1400

Pump Tank: Gallons; PT Date

Pump Make: Model Serial No

Nitrification Field: No Fields 1 Square Feet 1600 Linear Feet 535

No Lines 5@107' Trench Width 36" Max Trench Bottom Depth 36" Gravel Depth 12"

[X] New System [ ] Repair System Type: I (II) III IV V VI

System Description: Grav. Conv.

Repair System Description: Grav. 25% Red.

Maintenance Agreement Required: [ ] Yes [X] No

[X] House/Mod. Home No. Bedrooms 4

[ ] Mobile Home No. Bathrooms 3

[ ] Business No. Employees

[ ] Other


[ ] Slab [X] Crawl Space [ ] Basement w/plumbing [ ] Basement wo/plumbing

Water Supply: [X] Individual [ ] Public [ ] Community

Comments/Conditions: Keep well 100ft From Systom
Remove Terraces
Not to Scale

Comments/Conditions:

INITIAL SITE SKETCH

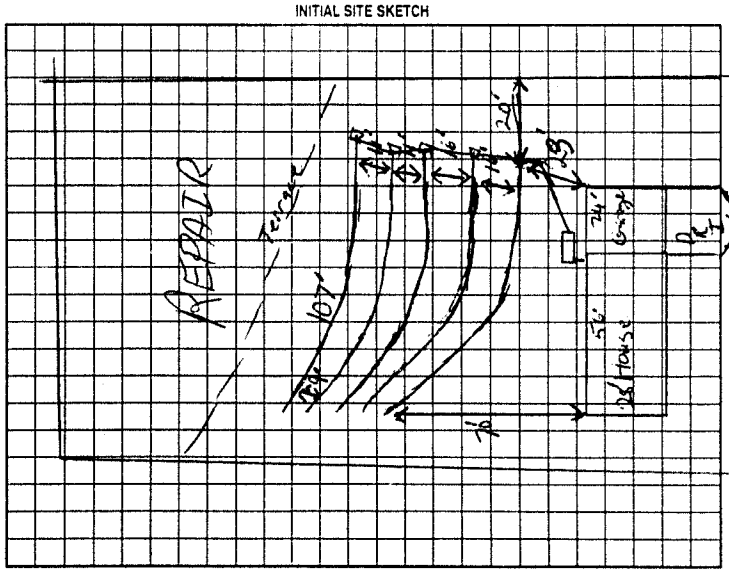

AS BUILT SKETCH

Permit can be suspended or revoked if any false information is supplied toward securing the permit/any unauthorized changes are made to the site/any unauthorized changes are made in the installation of the system. Improvement Permit with plat valid without expiration. Improvement Permit with site plan valid for sixty months. Authorization to Construct is valid for a period equal to that of Improvement Permit – not to exceed sixty months.

Signed Suzie Pruett, agent date 9-19-00 Installed by: A-1 Backhoe

Improvement Permit by: [signature] RS date 9/1/00 Operation Permit by: [signature] RS date 11-13-00

Authorization to Construct by: [signature] RS date 9/11/00 Existing System Inspection by: date

HEALTH DEPT. COPY WHITE OWNER COPY (FINAL) YELLOW OWNER COPY (INITIAL) PINK