IREDELL COUNTY HEALTH DEPARTMENT

Statesville Office (704) 878-5305 Mooresville Office (704) 660-3625 PERMIT # 20272|

IMPROVEMENT PERMIT / AUTHORIZATION TO CONSTRUCT / OPERATION PERMIT / EXISTING SYSTEM

PIN # 4629970644

APPLICANT: Regan Smith APPLICANT ADDRESS: 156 Hermance Ln

SITE ADDRESS: 411 Morrison Farm Rd PHONE: 704-363-8888 ALT. PHONE: N/A

SITE DIRECTIONS: Hwy 115 S TR Perth Rd TR State Park Rd TL Morrison Farm Rd.

SUBDIVISION: Morrison Pointe South SECTION: N/A LOT # 3428 LOT AREA: 40153 acres DESIGN FLOW: 100 gpd L.T.A.R.: 0.025

Septic Tank 1000 (gal) STB IM-1060 Date Infiltrator
Pump Tank (gal) PT Date
Pump Make Model Serial #
Nitrification Fields 1 # Lines 2 Linear Ft: 100'
Trench Width 36" Max. Trench Bottom Depth 36" Gravel Depth N/A


☑ New System ☐ Repair ☐ Expansion System Type: I II ☑ III IV V VI
System Description: 25% Reduction
Repair System Description: 25% Reduction
Maintenance Agreement Required: ☐ YES ☑ NO
☑ GRAVITY ☐ PRESSURE

☐ Residence No. Bedrooms
☐ Business No. Persons
☐ Other No. Employees
☑ Slab (garage w/ bath) ☐ Crawl Space
☐ Basement w/plumbing ☐ Basement w/o plumbing

Water Supply: ☑ Private ☐ Public ☐ Community

Comments / Conditions: Install a 25% Reduction system on contour with serial distribution.

INITIAL SITE SKETCH

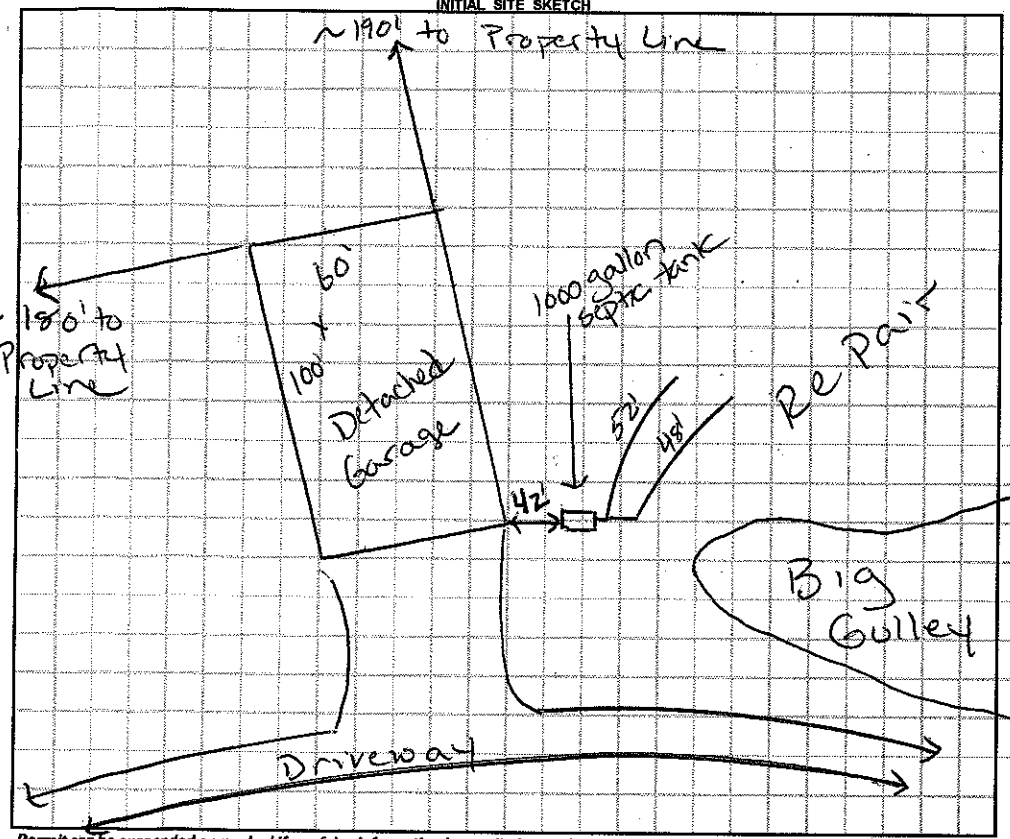

AS BUILT SKETCH

- Infiltrator IM-1060 ST installed w/ risers to grade
- Red Polylok Site: installed
- Quick 4 Chambers installed
- Installed as drawn

Permit can be suspended or revoked if any false information is supplied toward securing the permit / any unauthorized changes are made to the site / any unauthorized changes are made in the installation of the system. **CONTACT A LOCATOR SERVICE PRIOR TO ANY EXCAVATION**

☐ **IMPROVEMENT PERMIT** *with plat valid without expiration.* ☑ **IMPROVEMENT PERMIT** *with site plan valid for 60 mos.* ☑ **AUTHORIZATION TO CONSTRUCT** *valid for period equal to IMPROVEMENT PERMIT--not to exceed 60 mo.*

Owner / Applicant Signature: [signature] Date: 6-19-14 Installed by: Richard Abernathy Septic & Grading

IMPROVEMENT PERMIT by: Justin Henderson Date: 6-12-14 OPERATION PERMIT by: Justin Henderson Date: 11-19-15

AUTHORIZATION TO CONSTRUCT by: Justin Henderson Date: 6-12-14 Existing System Inspected by: Date:

Health Dept. Copy - WHITE Applicant (Final Approval) - YELLOW Applicant (Conditional Approval) - PINK