IREDELL COUNTY HEALTH DEPARTMENT

Statesville Office (704) 878-5305 Mooresville Office (704) 660-3625 PERMIT # 20273 B

IMPROVEMENT PERMIT / AUTHORIZATION TO CONSTRUCT / OPERATION PERMIT / EXISTING SYSTEM

PIN # 4629970644

APPLICANT: Ronnie Smith APPLICANT ADDRESS: 150 Hermance Ln.

SITE ADDRESS: 411 Morrison Farm Rd PHONE: 704-363-8888 ALT. PHONE: N/A


SITE DIRECTIONS: Hwy 21S TR Peth Rd TR State Park Rd TL Morrison Farm Rd

SUBDIVISION: Morrison Point South SECTION: N/A LOT # 3428 LOT AREA: 40.53 acres DESIGN FLOW: 480 gpd L.T.A.R.: 0.3


Septic Tank	1000 (gal)	STB	Date	☑ New System ☐ Repair ☐ Expansion	System Type: I II ☒ III IV V VI	☑ Residence	No. Bedrooms	4	Water Supply
Pump Tank	(gal)	PT	Date	System Description:	25% Reduction	☐ Business	No. Persons	8	☐ Private
Pump Make	Model		Serial #	Repair System Description:	25% Reduction	☐ Other	No. Employees		☑ Public
# Nitrification Fields	1 # Lines	4	Linear Ft: 400	Maintenance Agreement Required:	☐ YES ☑ NO	☑ Slab	☐ Crawl Space		☐ Community
Trench Width	36" Max. Trench Bottom Depth	36"	Gravel Depth N/A	☑ GRAVITY	☐ PRESSURE	☐ Basement w/plumbing		☐ Basement w/o plumbing	

Comments / Conditions: IMPROVEMENTS ONLY! Submit floor plan prior to issuance of CA. Install a 25% reduction system on contour with serial distribution.

INITIAL SITE SKETCH

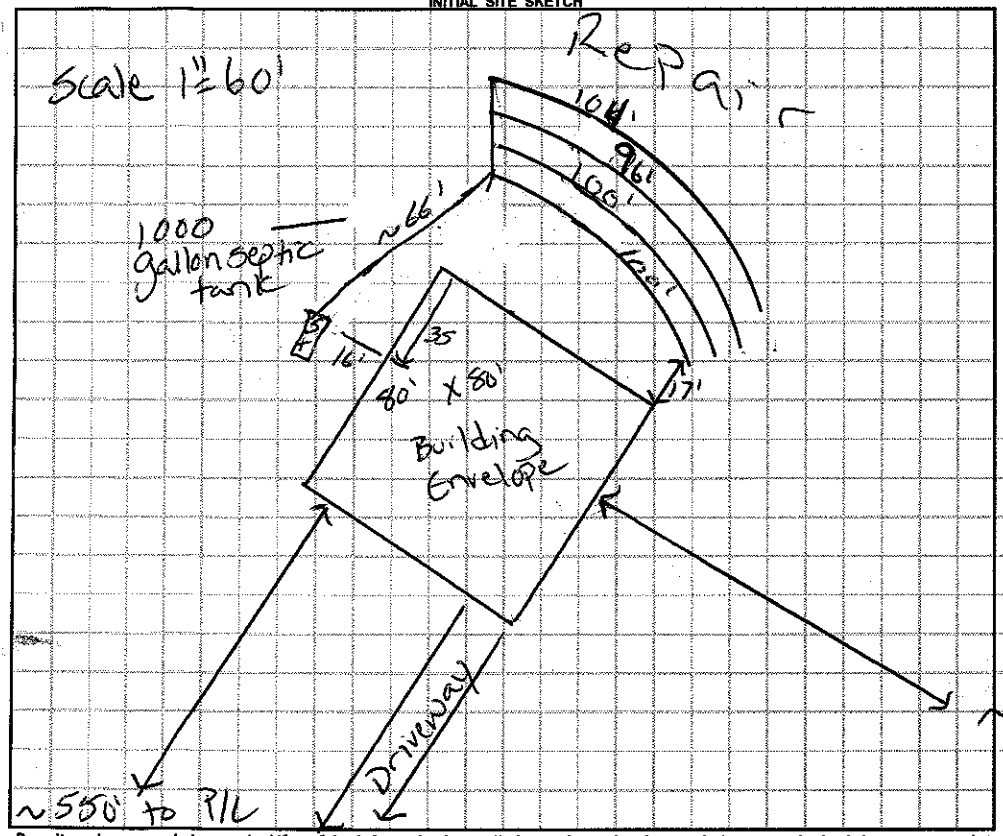

AS BUILT SKETCH

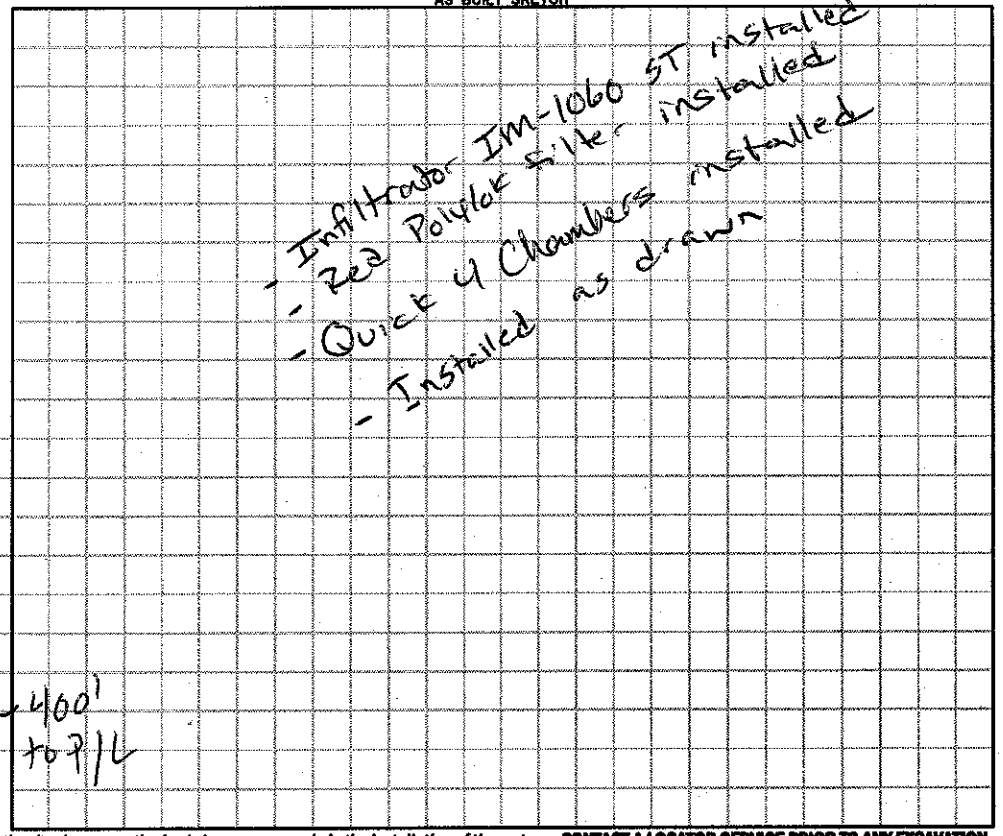

Permit can be suspended or revoked if any false information is supplied toward securing the permit / any unauthorized changes are made to the site / any unauthorized changes are made in the installation of the system. **CONTACT A LOCATOR SERVICE PRIOR TO ANY EXCAVATION**

☐ **IMPROVEMENT PERMIT** *with plat valid without expiration.* ☑ **IMPROVEMENT PERMIT** *with site plan valid for 60 mos.* ☑ **AUTHORIZATION TO CONSTRUCT** *valid for period equal to IMPROVEMENT PERMIT--not to exceed 60 mo.*

Owner / Applicant Signature: Ronnie L. Smith Date: 5-20-14 Installed by: Richard Abernathy Septic & Grading

IMPROVEMENT PERMIT by: Justin Henderson Date: 5-13-14 OPERATION PERMIT by: Justin Henderson Date: 11-19-15

AUTHORIZATION TO CONSTRUCT by: Justin Henderson Date: 5-15-14 Existing System Inspected by: Date:

Health Dept. Copy - WHITE Applicant (Final Approval) - YELLOW Applicant (Conditional Approval) - PINK