IREDELL COUNTY HEALTH DEPARTMENT

Statesville Office (704) 878-5305 Mooresville Office (704) 660-3625 PERMIT # 217561 ~~178310~~

IMPROVEMENT PERMIT / AUTHORIZATION TO CONSTRUCT / OPERATION PERMIT / EXISTING SYSTEM

PIN # ~~4639-09-4090.000~~ 4629-98-4731

APPLICANT: Mary Misciagna APPLICANT ADDRESS: 143 Mandarin Dr. Mooresville, NC 28117

SITE ADDRESS: 119 Stillwater Rd, Troutman, N.C. 28166 PHONE: ALT. PHONE:

SITE DIRECTIONS: Perth Rd Turn on State Park Rd. TL Morrison Farm Rd. TL Stillwater Rd. 1st lot on left

SUBDIVISION: Twin Coves @ Morrison SECTION: - LOT # 1 LOT AREA: 5.27Ac DESIGN FLOW: 480gpd L.T.A.R.: .3

Septic Tank	1000	(gal)	STB 794	Date 6/22/16	☒ New System	☐ Repair	☐ Expansion	System Type: I II III IV V VI	☒ Residence	No. Bedrooms 4	Water Supply
Pump Tank		(gal)	PT	Date	System Description:	Gravity 25% Reduction			☐ Business	No. Persons 8	☐ Private
Pump Make		Model		Serial #	Repair System Description:	Gravity 25% Reduction			☐ Other	No. Employees	☒ Public
# Nitrification Fields	1	# Lines	1200	Linear Ft: 400	Maintenance Agreement Required:	☐ YES	☒ NO		☐ Slab	☒ Crawl Space	☐ Community
Trench Width	36"	Max. Trench Bottom Depth	36"	Gravel Depth NA		☒ GRAVITY	☐ PRESSURE		☐ Basement w/plumbing		☐ Basement w/o plumbing

Comments / Conditions:

3 BR Floor Plans Turned in Poc Alc.

INITIAL SITE SKETCH

SEE Attached Plan from Toney Jacobs, LSS

AS BUILT SKETCH

Permit can be suspended or revoked if any false information is supplied toward securing the permit / any unauthorized changes are made to the site / any unauthorized changes are made in the installation of the system. CONTACT A LOCATOR SERVICE PRIOR TO ANY EXCAVATION

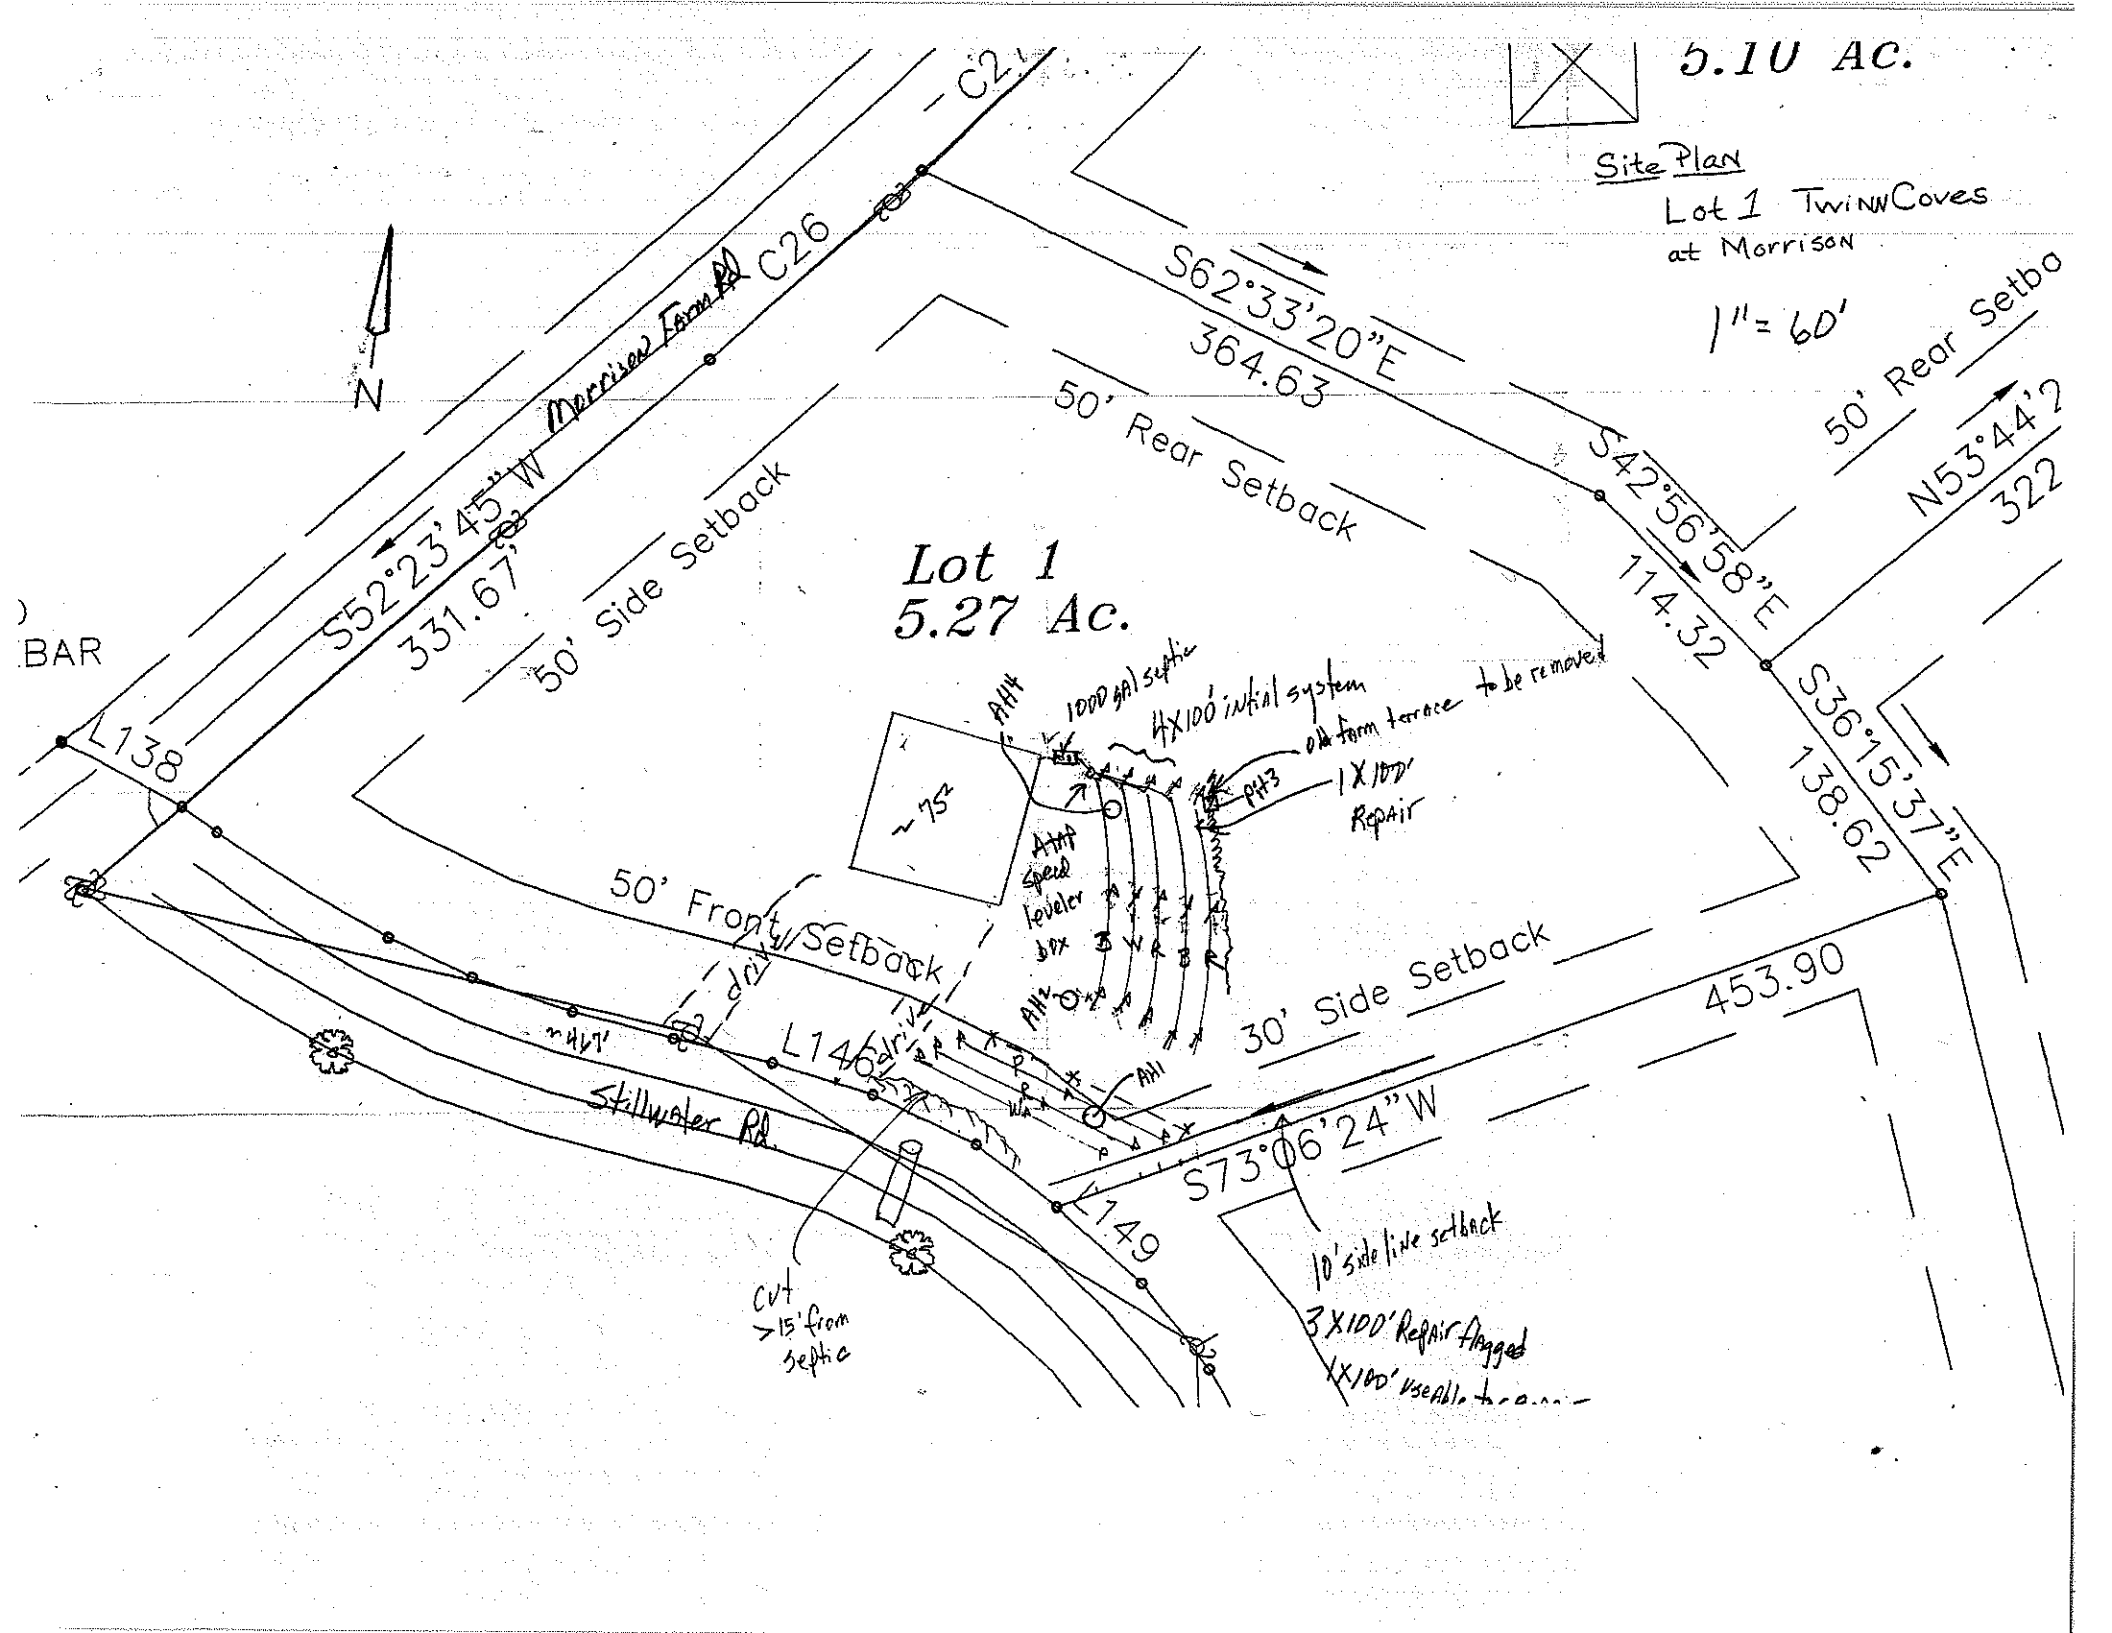
☐ IMPROVEMENT PERMIT with plat valid without expiration. ☒ IMPROVEMENT PERMIT with site plan valid for 60 mos. ☒ AUTHORIZATION TO CONSTRUCT valid for period equal to IMPROVEMENT PERMIT...not to exceed 60 mo.

Owner / Applicant Signature: [signature] Date: 4/29/13 Installed by: Richard Abernathy

IMPROVEMENT PERMIT by: [signature], REHS Date: 4-29-13 OPERATION PERMIT by: [signature] Date: 8/24/16

AUTHORIZATION TO CONSTRUCT by: [signature] Date: 3/14/16 Existing System Inspected by: Date:

Health Dept. Copy - WHITE Applicant (Final Approval) - YELLOW Applicant (Conditional Approval) - PINK


5.10 Ac.
Site Plan
Lot 1 Twin Coves at Morrison
1" = 60'
N
C26
Morrison Farm Rd
S62°33'20"E
364.63
50' Rear Setback
S42°56'58"E
114.32
50' Rear Setbo
N53°44'2
322
S52°23'45"W
331.67'
50' Side Setback
Lot 1
5.27 Ac.
L138
BAR
1000 gal septic
4X100' initial system
old farm terrace to be removed
1X100' Repair
~75'
50' Front Setback
drive
~417'
L140
Stillwater Rd.
30' Side Setback
S36°15'37"E
138.62
453.90
S73°06'24"W
L149
cut >15' from septic
10' side line setback
3X100' Repair flagged
4X100' useable