This Permit Replaces previous one issued 4-29-13

IREDELL COUNTY HEALTH DEPARTMENT

Statesville Office (704) 878-5305 Mooresville Office (704) 660-3625 PERMIT # 203295

IMPROVEMENT PERMIT / AUTHORIZATION TO CONSTRUCT / OPERATION PERMIT / EXISTING SYSTEM

PIN # 4629997025

APPLICANT: Ronald Bauguss APPLICANT ADDRESS: 249 Apache Rd

SITE ADDRESS: 335 Morrison Farm Rd PHONE: 704-458-2302 ALT. PHONE: N/A

SITE DIRECTIONS: HWY 21S TR Perth Rd TR State Park Rd TL Morrison Farm Rd.

SUBDIVISION: Twinn Coves on Morrison SECTION: N/A LOT # 6 LOT AREA: 5.1 acres DESIGN FLOW: 360gpd L.T.A.R.: 0.25

Septic Tank 1000 (gal) STB 794-1000 Date 5-18-15
Pump Tank (gal) PT Date
Pump Make Model Serial #
Nitrification Fields 1 # Lines 3 Linear Ft: 360
Trench Width 36" Max. Trench Bottom Depth 36" Gravel Depth N/A


☐ New System ☐ Repair ☐ Expansion System Type: I II (III) IV V VI
System Description: 25% Reduction
Repair System Description: 25% Reduction
Maintenance Agreement Required: ☐ YES ☑ NO
☑ GRAVITY ☐ PRESSURE

☑ Residence ☐ Business ☐ Other ☐ Slab ☐ Basement w/plumbing
No. Bedrooms 3 No. Persons 6 No. Employees
☑ Crawl Space ☐ Basement w/o plumbing


Water Supply: ☐ Private ☑ Public ☐ Community

Comments / Conditions: Install a 25% Reduction system on contour with serial distribution.

INITIAL SITE SKETCH

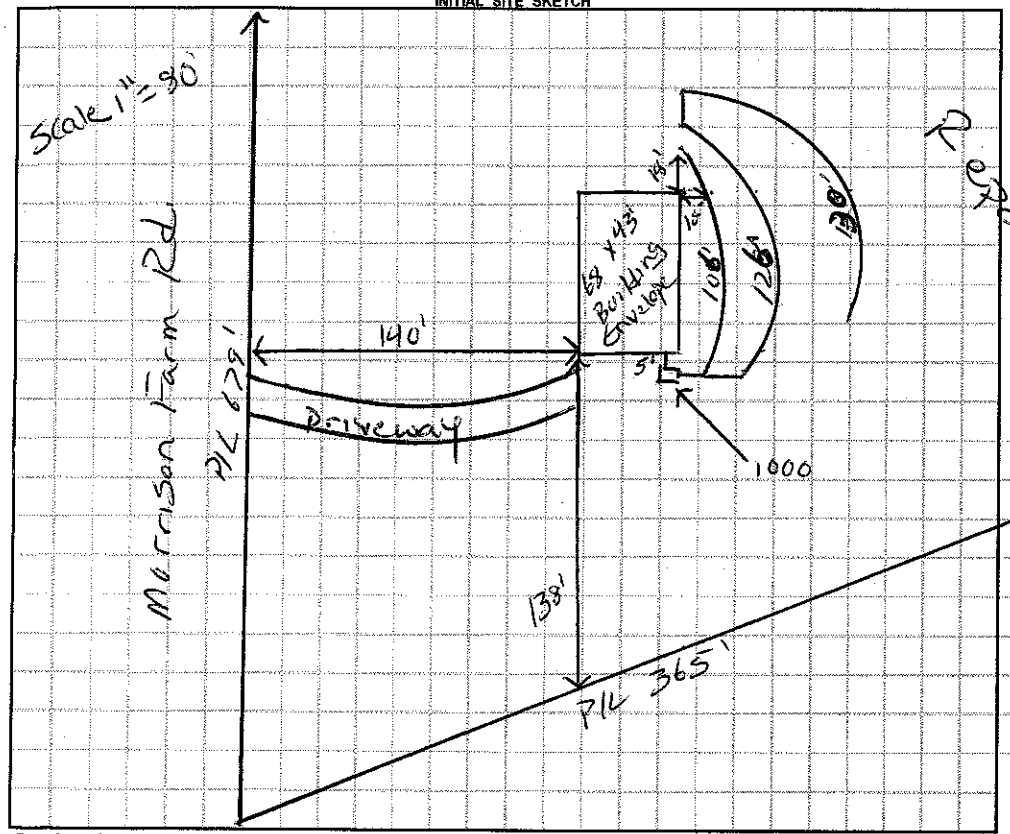

AS BUILT SKETCH

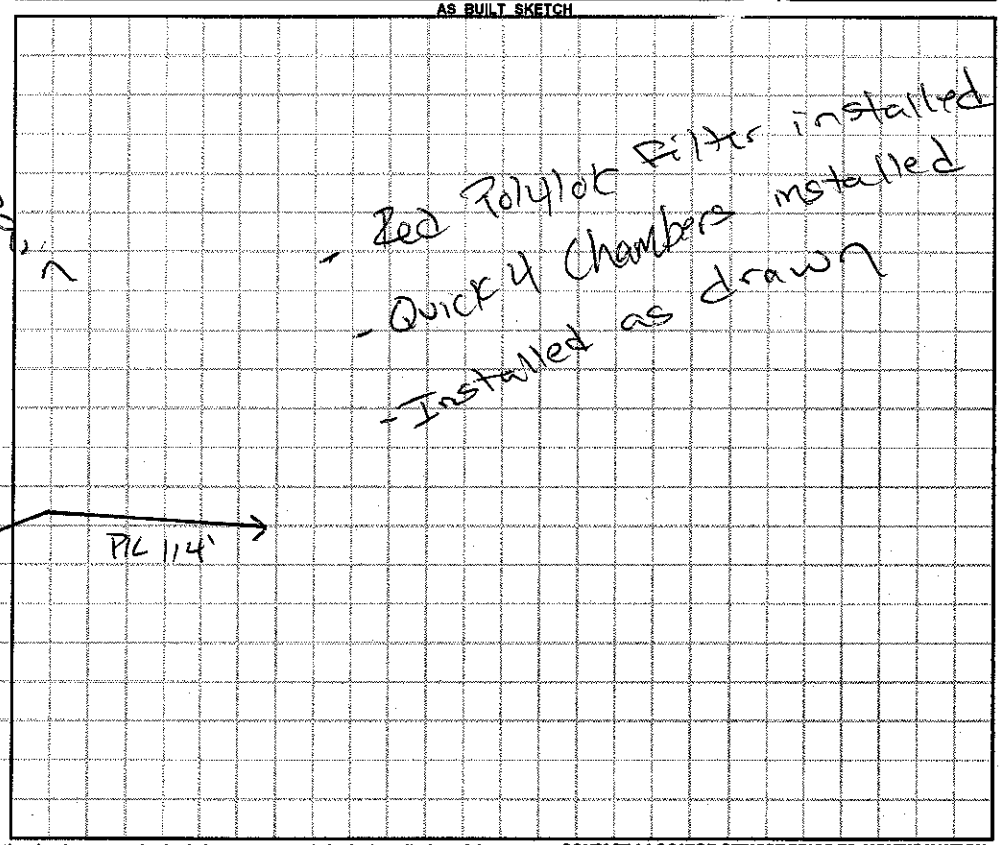

Permit can be suspended or revoked if any false information is supplied toward securing the permit / any unauthorized changes are made to the site / any unauthorized changes are made in the installation of the system. **CONTACT A LOCATOR SERVICE PRIOR TO ANY EXCAVATION**

☐ **IMPROVEMENT PERMIT** *with plat valid without expiration.* ☑ **IMPROVEMENT PERMIT** *with site plan valid for 60 mos.* ☑ **AUTHORIZATION TO CONSTRUCT** *valid for period equal to IMPROVEMENT PERMIT--not to exceed 60 mo.*

Owner / Applicant Signature: Ronald Bauguss Date: 6-17-14 Installed by: Richard Abernathy

IMPROVEMENT PERMIT by: Justin Henderson Date: 6-17-14 OPERATION PERMIT by: Justin Henderson Date: 6-24-15

AUTHORIZATION TO CONSTRUCT by: Justin Henderson Date: 6-17-14 Existing System Inspected by: Date:

Health Dept. Copy - WHITE Applicant (Final Approval) - YELLOW Applicant (Conditional Approval) - PINK

This permit replaces previous one issued 3-25-13

IREDELL COUNTY HEALTH DEPARTMENT

Statesville Office (704) 878-5305 Mooresville Office (704) 660-3625 PERMIT # 177299

IMPROVEMENT PERMIT / AUTHORIZATION TO CONSTRUCT / OPERATION PERMIT / EXISTING SYSTEM

PIN # 4639094090

APPLICANT: Ron Baugus APPLICANT ADDRESS: 249 Apache Rd.

SITE ADDRESS: Morrison Farm Rd. PHONE: 704-458-2302 ALT. PHONE: N/A


SITE DIRECTIONS: Hwy 21 S TR Perth Rd TR State Park Rd. TL Morrison Farm Rd.

SUBDIVISION: Twin Coves SECTION: N/A LOT # 6 LOT AREA: 5.1 acres DESIGN FLOW: 480gpd L.T.A.R.: 0.25


Septic Tank	1000 (gal)	STB	Date	☑ New System	☐ Repair	☐ Expansion	System Type: I II ☑III IV V VI	☑ Residence	No. Bedrooms	4	Water Supply
Pump Tank	(gal)	PT	Date	System Description:	25% Reduction			☐ Business	No. Persons		☐ Private
Pump Make	Model		Serial #	Repair System Description:	25% Reduction			☐ Other	No. Employees		☑ Public
# Nitrification Fields	1 # Lines	4	Linear Ft: 480	Maintenance Agreement Required:	☐ YES	☑ NO		☐ Slab	☑ Crawl Space		☐ Community
Trench Width	36" Max. Trench Bottom Depth	36"	Gravel Depth N/A		☑ GRAVITY	☐ PRESSURE		☐ Basement w/plumbing			☐ Basement w/o plumbing

Comments / Conditions: Install a 25% Reduction system on contour with serial distribution.

INITIAL SITE SKETCH

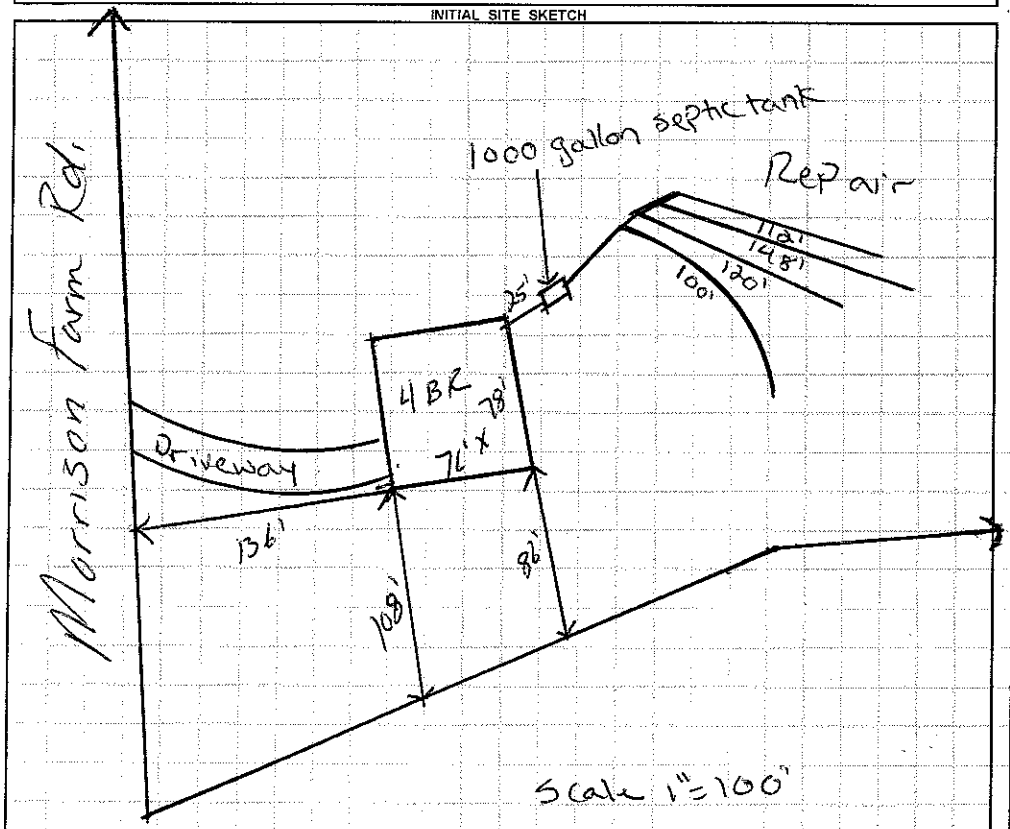

AS BUILT SKETCH

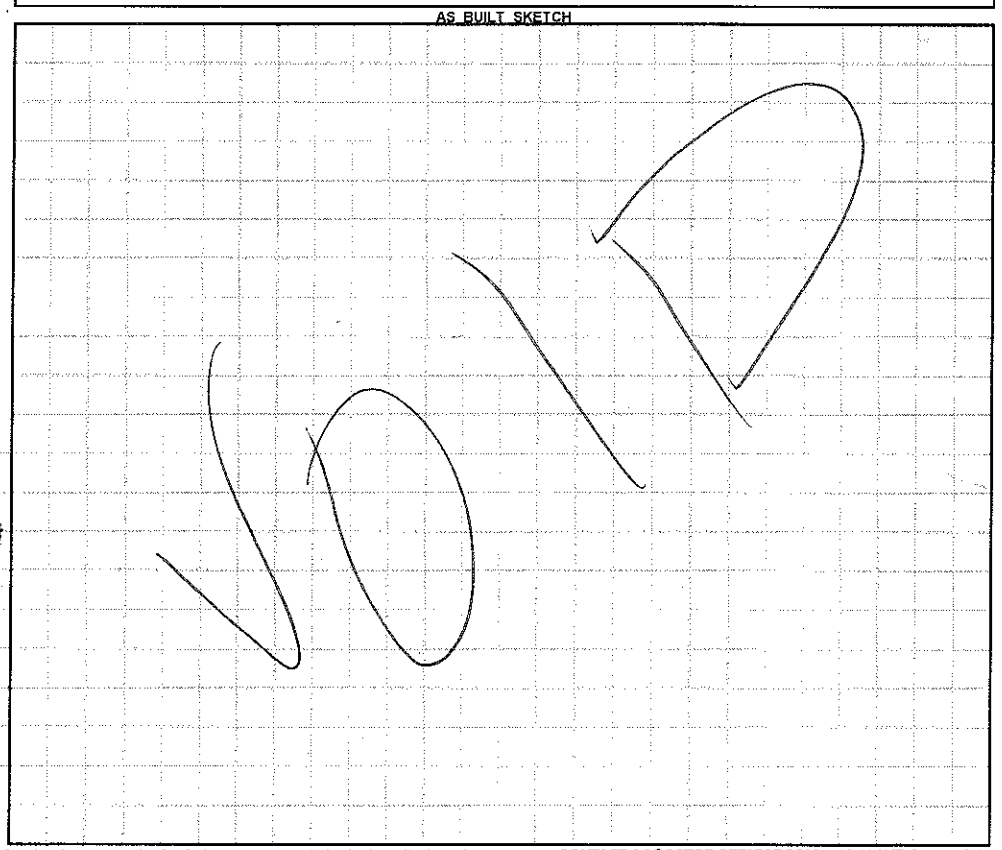

Permit can be suspended or revoked if any false information is supplied toward securing the permit / any unauthorized changes are made to the site / any unauthorized changes are made in the installation of the system. **CONTACT A LOCATOR SERVICE PRIOR TO ANY EXCAVATION**

☐ **IMPROVEMENT PERMIT** *with plat valid without expiration.* ☑ **IMPROVEMENT PERMIT** *with site plan valid for 60 mos.* ☑ **AUTHORIZATION TO CONSTRUCT** *valid for period equal to IMPROVEMENT PERMIT--not to exceed 60 mo.*

Owner / Applicant Signature: Ron Baugus Date: 4-30-13 Installed by:

IMPROVEMENT PERMIT by: Justin Henderson Date: 4-29-13 OPERATION PERMIT by: Date:

AUTHORIZATION TO CONSTRUCT by: Justin Henderson Date: 4-29-13 Existing System Inspected by: Date:

Health Dept. Copy - WHITE Applicant (Final Approval) - YELLOW Applicant (Conditional Approval) - PINK

IREDELL COUNTY HEALTH DEPARTMENT

Statesville Office (704) 878-5305 Mooresville Office (704) 660-3625 PERMIT # 177299

IMPROVEMENT PERMIT / AUTHORIZATION TO CONSTRUCT / OPERATION PERMIT / EXISTING SYSTEM

PIN # 4639094090

APPLICANT: Ronald Bauguss APPLICANT ADDRESS: 249 Apache Rd.

SITE ADDRESS: Morrison Farm Rd. PHONE: 704-458-2302 ALT. PHONE: N/A


SITE DIRECTIONS: Hwy 21 S TR Perth Rd TR State Park Rd. TL Morrison Farm Rd.

SUBDIVISION: Twin Coves SECTION: N/A LOT # 6 LOT AREA: 5.1 acres DESIGN FLOW: 600gpd L.T.A.R.: 0.35


Septic Tank	1500 (gal)	STB	Date	☑ New System	☐ Repair	☐ Expansion	System Type: I II (III) IV V VI	☑ Residence	No. Bedrooms	5	Water Supply
Pump Tank	(gal)	PT	Date	System Description:	25% Reduction			☐ Business	No. Persons		☐ Private
Pump Make	Model		Serial #	Repair System Description:	25% Reduction			☐ Other	No. Employees		☑ Public
# Nitrification Fields	1 # Lines	5	Linear Ft: 600	Maintenance Agreement Required:	☐ YES	☑ NO		☐ Slab	☐ Crawl Space		☐ Community
Trench Width	36" Max. Trench Bottom Depth	36"	Gravel Depth N/A		☑ GRAVITY	☐ PRESSURE		☑ Basement w/ plumbing		☐ Basement w/o plumbing	

Comments / Conditions: Install a 25% Reduction system on contour with serial distribution.

INITIAL SITE SKETCH

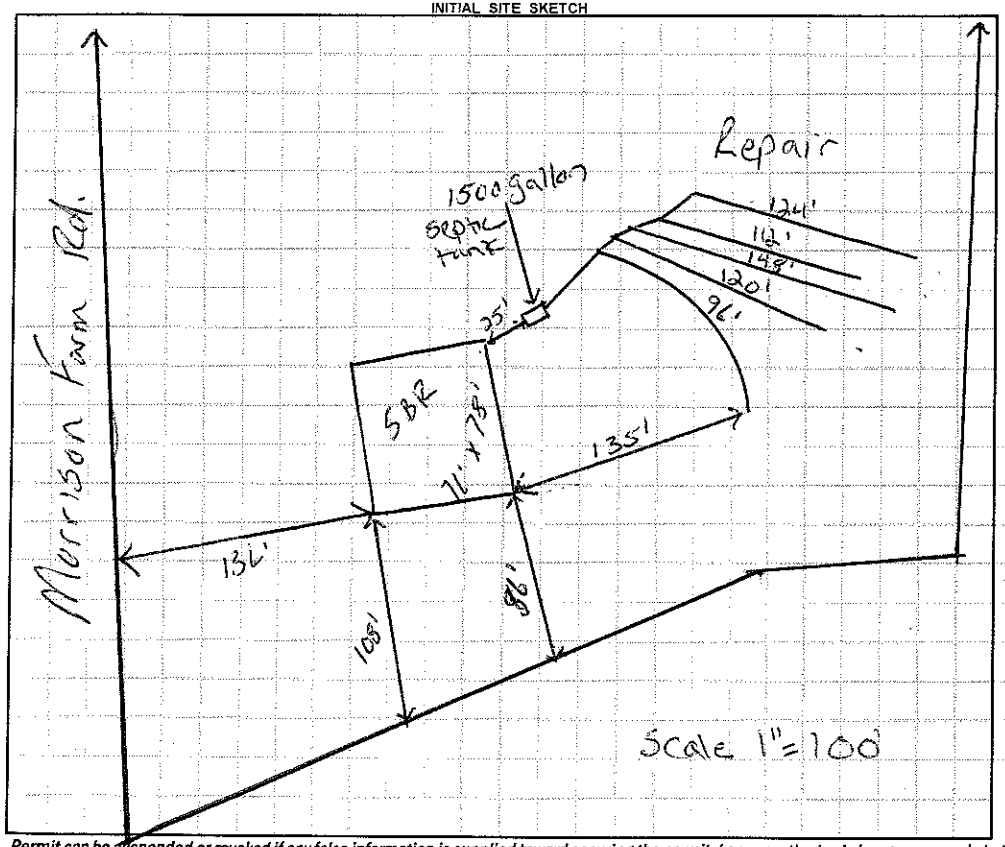

AS BUILT SKETCH

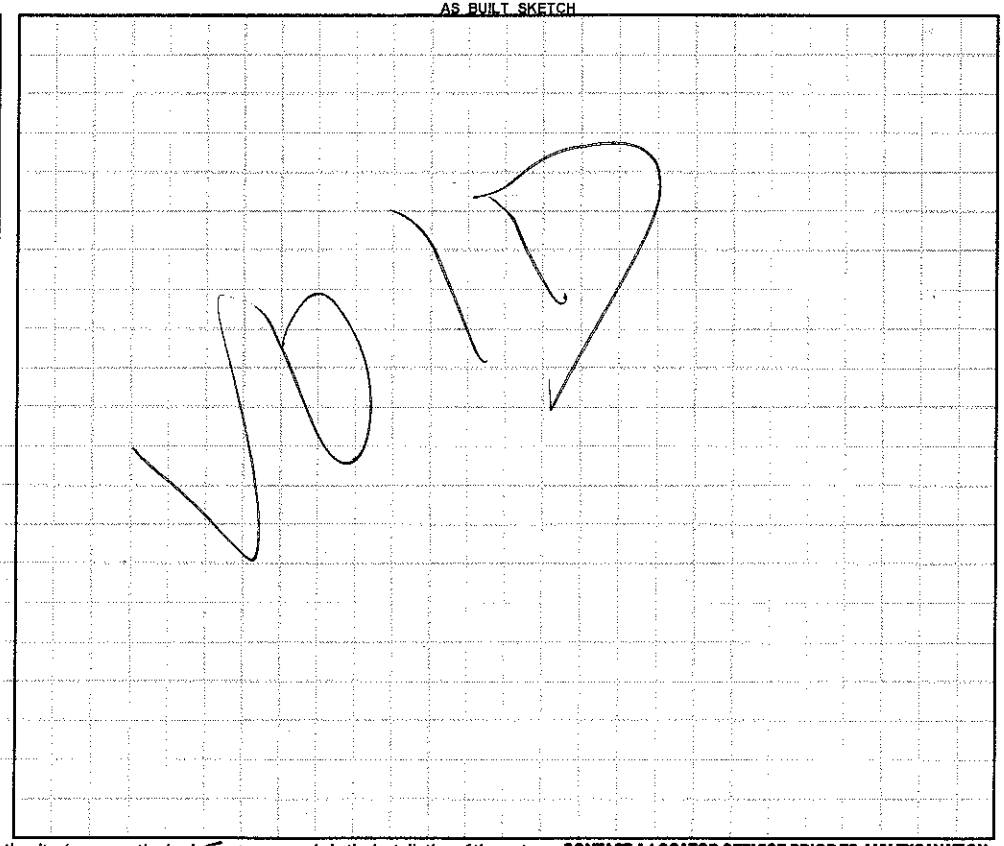

Permit can be suspended or revoked if any false information is supplied toward securing the permit / any unauthorized changes are made to the site / any unauthorized changes are made in the installation of the system. **CONTACT A LOCATOR SERVICE PRIOR TO ANY EXCAVATION**

☐ **IMPROVEMENT PERMIT** ***with plat*** *valid without expiration.* ☐ **IMPROVEMENT PERMIT** ***with site plan*** *valid for 60 mos.* ☑ **AUTHORIZATION TO CONSTRUCT** *valid for period equal to IMPROVEMENT PERMIT--not to exceed 60 mo.*

Owner / Applicant Signature: Ronald Bauguss Date: 3-26-13 Installed by:

IMPROVEMENT PERMIT by: Justin Henderson Date: 3-25-13 OPERATION PERMIT by: Date:

AUTHORIZATION TO CONSTRUCT by: Justin Henderson Date: 3-25-13 Existing System Inspected by: Date:

Health Dept. Copy - WHITE Applicant (Final Approval) - YELLOW Applicant (Conditional Approval) - PINK