2130

IREDELL COUNTY HEALTH DEPARTMENT

STATESVILLE 704-878-5305 MOORESVILLE 704-664-5281

IMPROVEMENT PERMIT / AUTHORIZATION TO CONSTRUCT / OPERATION PERMIT / EXISTING SYSTEM INSPECTION

PERMIT# 010222 PIN# 4634 59 5879 DATE 1/22/04

OWNER OR CONTRACTOR Marcus F. Snoddy PHONE: Business 704-896-7227 Home

ADDRESS 157 Schooner Rd. Mooresville, NC. 28117

LOCATION Langtree Rd. TR Schooner Rd. on (L) just past Teakwood Rd.

SUBDIVISION Sanders Lair BLOCK / SECTION LOT 26 LOT AREA .63Ac SITE CLASS. PS DESIGN FLOW 600 L.T.A.R. .35

Septic Tank: EXIST. 1250 Gallons; STB Date

Pump Tank: EXIST. 1000 Gallons; PT Date

Pump Make: Model Serial No.

Nitrification Field: No Fields Square Feet 280 Linear Feet 140

No Lines 5 Trench Width 2' Max Trench Bottom Depth 3' Gravel Depth No

[X] New System [ ] Repair System Type: I, II, III, IV, V, VI

System Description: Addition - 16" PBBPS - Pressure Dosed

Repair System Description: NONE

Maintenance Agreement Required: [X] Yes [ ] No

[X] House/Mod. Home No. Bedrooms 5

[ ] Mobile Home No. Bathrooms 5.5

[ ] Business No. Employees


[ ] Other

[ ] Slab [ ] Crawl Space [X] Basement w/plumbing [ ] Basement wo/plumbing

Water Supply: [X] Individual [ ] Public [ ] Community

Comments:/Conditions: HOUSE

INITIAL SITE SKETCH

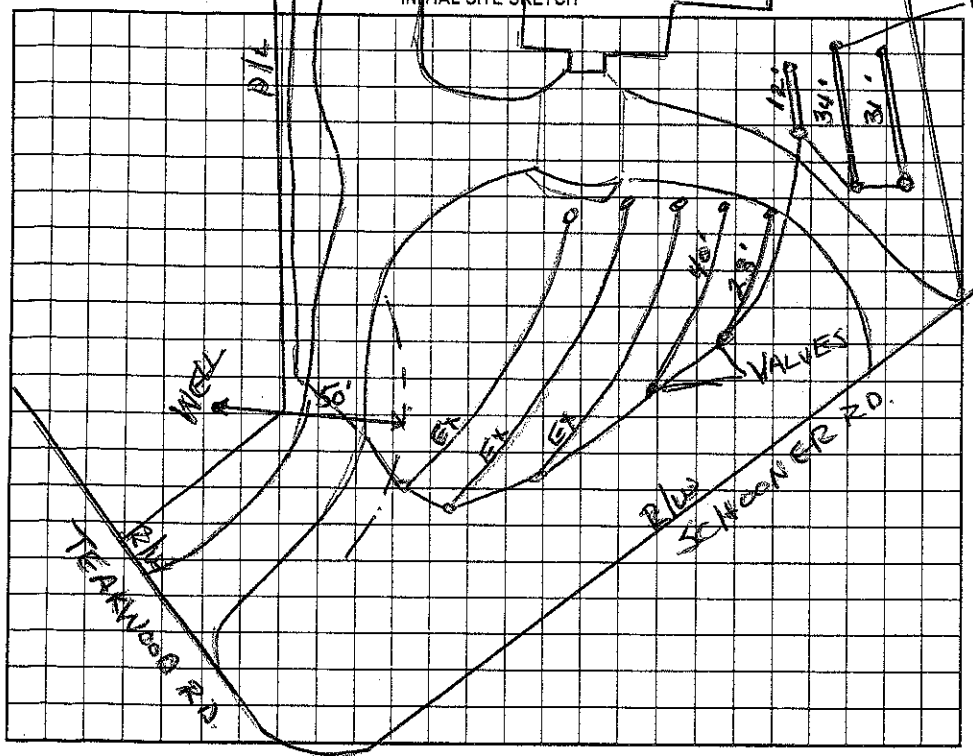

Comments:/Conditions: * Make sure the Specifics from Booklet is given to the person who picks up this permit. Lews installed as shown on A.C. 3/31/04

AS BUILT SKETCH

Permit can be suspended or revoked if any false information is supplied toward securing the permit/any unauthorized changes are made to the site/any unauthorized changes are made in the installation of the system. Improvement Permit with plat valid without expiration. Improvement Permit with site plan valid for sixty months. Authorization to Construct is valid for a period equal to that of Improvement Permit – not to exceed sixty months.

Signed: * date 1/22/04 Installed by: Stanley Septic Service

Improvement Permit by: Wesley Sparks R.S. date 1/22/04 Operation Permit by: Wesley Sparks R.S. date 3/31/04

Authorization to Construct by: Wesley Sparks R.S. date 1/22/04 Existing System Inspection by: date

HEALTH DEPT. COPY: WHITE OWNER COPY (FINAL): YELLOW OWNER COPY (INITIAL): PINK