9:30

IREDELL COUNTY HEALTH DEPARTMENT

STATESVILLE 704-878-5305 (D) MOORESVILLE 704-664-5281

IMPROVEMENT PERMIT / AUTHORIZATION TO CONSTRUCT / OPERATION PERMIT / EXISTING SYSTEM INSPECTION

PERMIT# 104814 PIN# 4634 59 ~~4315~~ 6381 DATE 2/21/02

OWNER OR CONTRACTOR Walter Hefner PHONE: Business 704-506-2100 Home

ADDRESS 148 Teakwood Ln. Mooresville, NC. 28117

LOCATION 1155 TR Longtree Rd. to end TR Sailors Lair TL Teakwood to culdesac # 148

SUBDIVISION Sailors Lair BLOCK / SECTION LOT 39 LOT AREA >20,000 FT² SITE CLASS. PS DESIGN FLOW 360 L.T.A.R. N/A

Septic Tank: 1000 Gallons; STB 194 Date 4-16-02
Pump Tank: Gallons; PT Date
Pump Make: Model Serial No.
Nitrification Field: No Fields EXISTING System
No Lines Trench Width Max Trench Bottom Depth Gravel Depth

☐ New System ☒ Repair System Type: I (II) III, IV, V, VI
System Description: Adding new S/T
Repair System Description:
Maintenance Agreement Required: ☐ Yes ☒ No


☒ House/Mod. Home No. Bedrooms 3
☐ Mobile Home No. Bathrooms 2
☐ Business No. Employees
☐ Other
☐ Slab ☒ Crawl Space ☐ Basement w/plumbing ☐ Basement wo/plumbing

Water Supply:
☒ Individual
☐ Public
☐ Community


Comments:/Conditions:
TEAKWOOD LN.

Comments:/Conditions:

INITIAL SITE SKETCH

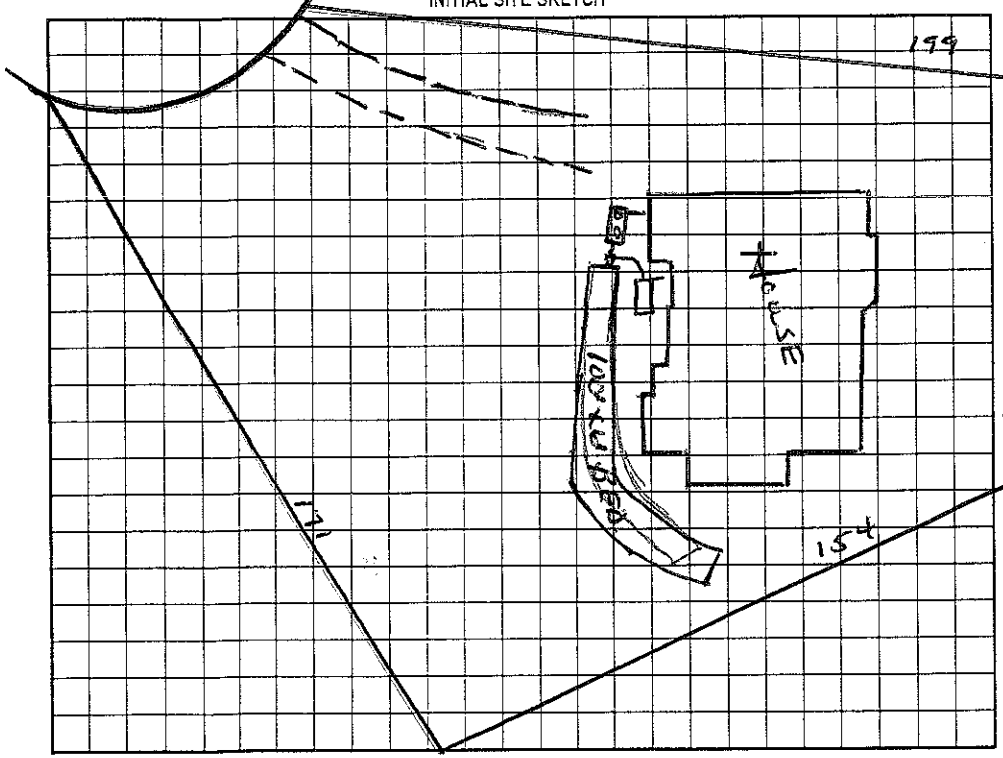

AS BUILT SKETCH

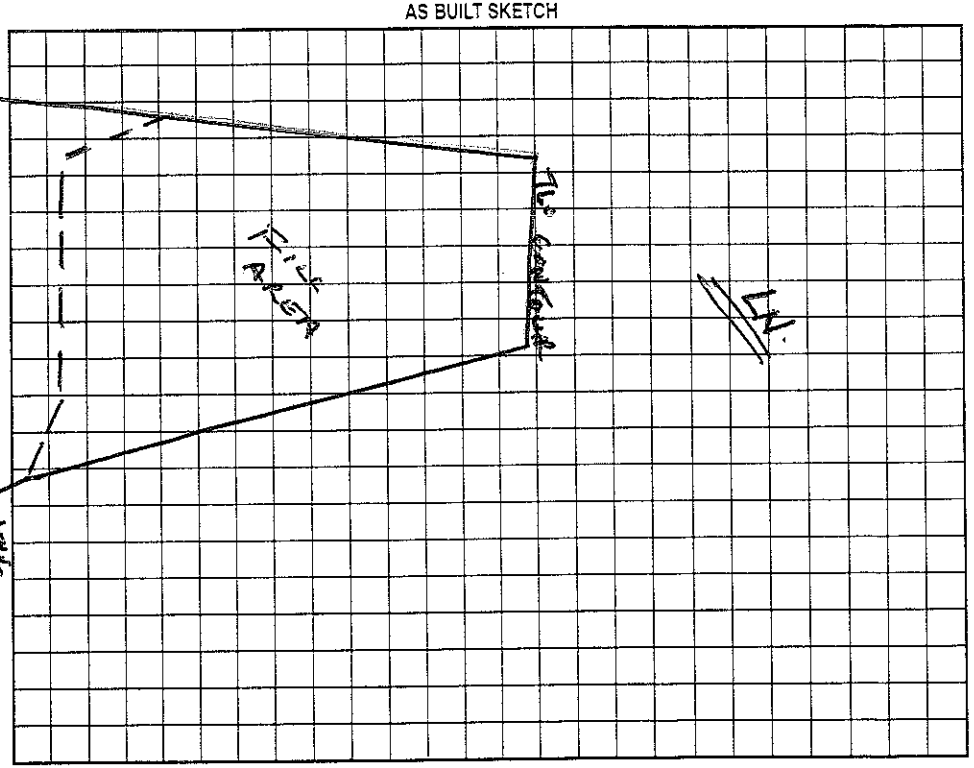

Permit can be suspended or revoked if any false information is supplied toward securing the permit/any unauthorized changes are made to the site/any unauthorized changes are made in the installation of the system. Improvement Permit with plat valid without expiration. Improvement Permit with site plan valid for sixty months. Authorization to Construct is valid for a period equal to that of Improvement Permit – not to exceed sixty months.

Signed: * date 2-21-02

Improvement Permit by: Wesley Sparks RS. date 2/21/02

Authorization to Construct by: Wesley Sparks RS date 2/21/02

Installed by: C. Wayne Orbison

Operation Permit by: Maria Dobson RS date 8/6/2002

Existing System Inspection by: date

HEALTH DEPT. COPY: WHITE OWNER COPY (FINAL): YELLOW OWNER COPY (INITIAL): PINK