IREDELL COUNTY HEALTH DEPARTMENT

STATESVILLE 704-878-5305 MOORESVILLE 704-664-5281

IMPROVEMENT PERMIT / AUTHORIZATION TO CONSTRUCT / OPERATION PERMIT / EXISTING SYSTEM INSPECTION

PERMIT # 1626000 PIN # 4634-69-1285 DATE 8-19-10

OWNER or APPLICANT MARK McMAHN PHONE: Business 704-237-4420 Home:

OWNER or APPLICANT ADDRESS 107 SAILHIGH CT MOORESVILLE 28117

LOCATION / DIRECTIONS LANETREE TO END, TR SCHOONER, CORNER OF SCHOONER & TEAKWOOD

SUBDIVISION SAILORS LAIR BLOCK / SECTION LOT # 43 LOT AREA .64 AC DESIGN FLOW 480 GPD L.T.A.R. .5

Septic Tank 1000 Gallons: STB 794 Date 10-22-11

Pump Tank Gallons: PT Date

Pump Make Model Serial #

Nitrification Field No Fields 1 No Lines 6 Linear Feet 400'

Trench Width 36" Max. Trench Bottom Depth 36" Gravel Depth —

☒ New System ☐ Repair ☐ Expansion System Type I II (III) IV V VI

System Description: GRAVITY 25% REDUCTION

Repair System Description: LP- PANEL BLOCK

Maintenance Agreement Required ☐ YES ☒ NO INITIALLY

☒ GRAVITY ☐ PRESSURE


☒ Residence No. Bedrooms 4 ☐ Business No. Persons ☐ Other No. Employees ☐ Slab ☒ Crawl Space ☐ Basement w/plumbing ☐ Basement w/o plumbing

Water Supply: ☒ Private ☐ Public ☐ Community

Comments / Conditions: 1) MEET ALL REQUIRED SETBACKS 2) SEPTIC MUST BE 15' MIN FROM POOL AREA & 50' MIN FROM ANY WELL

Comments / Conditions

INITIAL SITE SKETCH

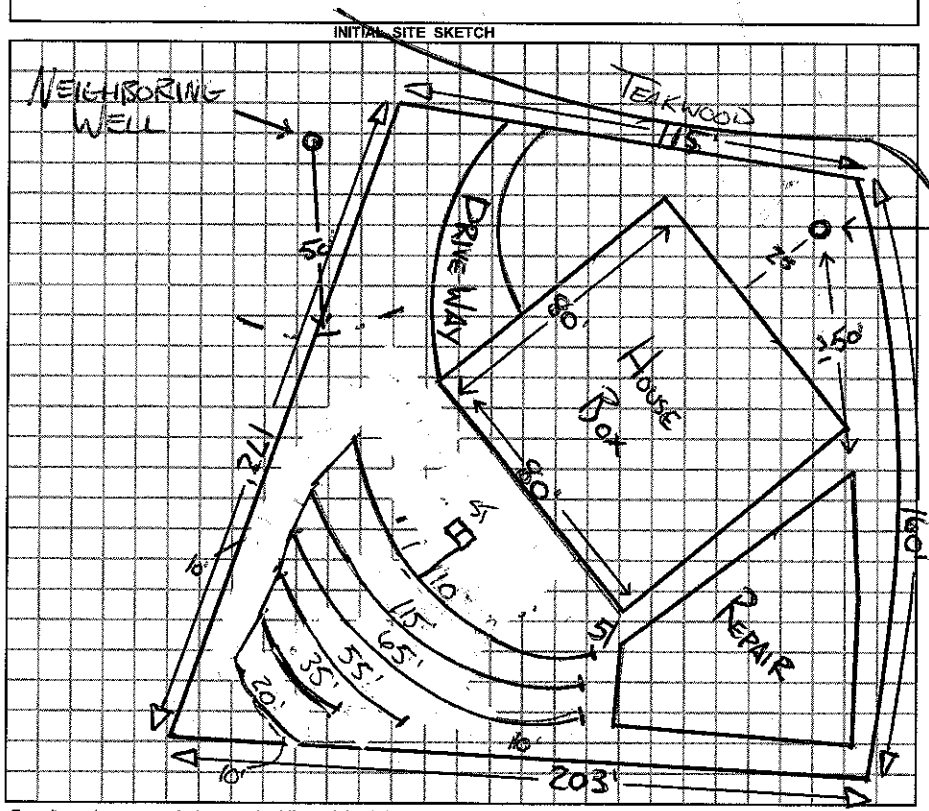

AS BUILT SKETCH

1" = 50'

Permit can be suspended or revoked if any false information is supplied toward securing the permit / any unauthorized changes are made to the site / any unauthorized changes are made in the installation of the system.

☐ *IMPROVEMENT PERMIT w / plat valid without expiration.* ☐ *IMPROVEMENT PERMIT w / site plan valid for 60 mos.* ☒ *AUTHORIZATION TO CONSTRUCT valid for period equal to IMPROVEMENT PERMIT-not to exceed 60 mo.*

Owner / Applicant Signature: Mark McMahn Date 8-19-10

Improvement Permit by: REHS Date 8-18-10

Authorization to Construct by: REHS Date 8-18-10

YOU SHOULD CONTACT A LOCATOR SERVICE PRIOR TO ANY EXCAVATION.

Installed by: JST

Operation Permit by: REHS Date: 12-5-11

Existing System Inspected by: Date:

WHITE COPY Environmental Health YELLOW COPY (Final) Owner / Applicant PINK COPY (Initial) Owner / Applicant