4634693017

IREDELL COUNTY HEALTH DEPARTMENT

STATESVILLE 704-878-5305 MOORESVILLE 704-664-5281

IMPROVEMENT PERMIT / CERTIFICATE OF COMPLETION / OPERATION PERMIT / EXISTING SYSTEM INSPECTION

PROPERTY DESCRIPTION NO. 18132 DATE May 16, '94 TAX MAP NO. 2B2A 45 Watershed: ☑ Yes ☐ No

OWNER OR CONTRACTOR Paul Hayn PHONE: Business Home 593-0056 L.M.

ADDRESS 12104 Meadow Park Lane, Charlotte NC 28269

LOCATION SR1102, on Rt. at jct w/ Schooner Lane

SUBDIVISION Lakes Ferry BLOCK / SECTION LOT 45 LOT AREA 110'X198' SITE CLASS PS DESIGN FLOW 360gpd L.T.A.R. .03

Septic Tank: 1000 Gallons; STB ~~[illegible]~~ Date 5-11-94

Pump Tank: Gallons; ~~PT~~ ~~525~~ RST Date

Pump Make: Model Serial No.

Nitrification Field: No Fields 1 Square Feet 1200 Linear Feet 400

No Lines 3 Trench Width 36" Max Trench Bottom Depth 28" Gravel Depth 12"

☑ New System ☐ Repair System Type: I, II, III, IV, V, VI

System Description: gravity conventional

Repair System Description: 1 pumped conv or PPBIS

Maintenance Agreement Required: ☐ Yes ☑ No

☑ House/Mod. Home ☐ Mobile Home ☐ Business ☐ Other

No. Bedrooms 3 No. Bathrooms 2 No. Employees


☐ Slab ☑ Crawl Space ☐ Basement w/plumbing ☐ Basement wo/plumbing

Water Supply: ☑ Individual ☐ Community ☐ Public


Comments: Exit plumbing from house at existing grade. Keep nitrification field shallow and deeper than specified trench bottom depth.

Comments:

INITIAL SITE SKETCH

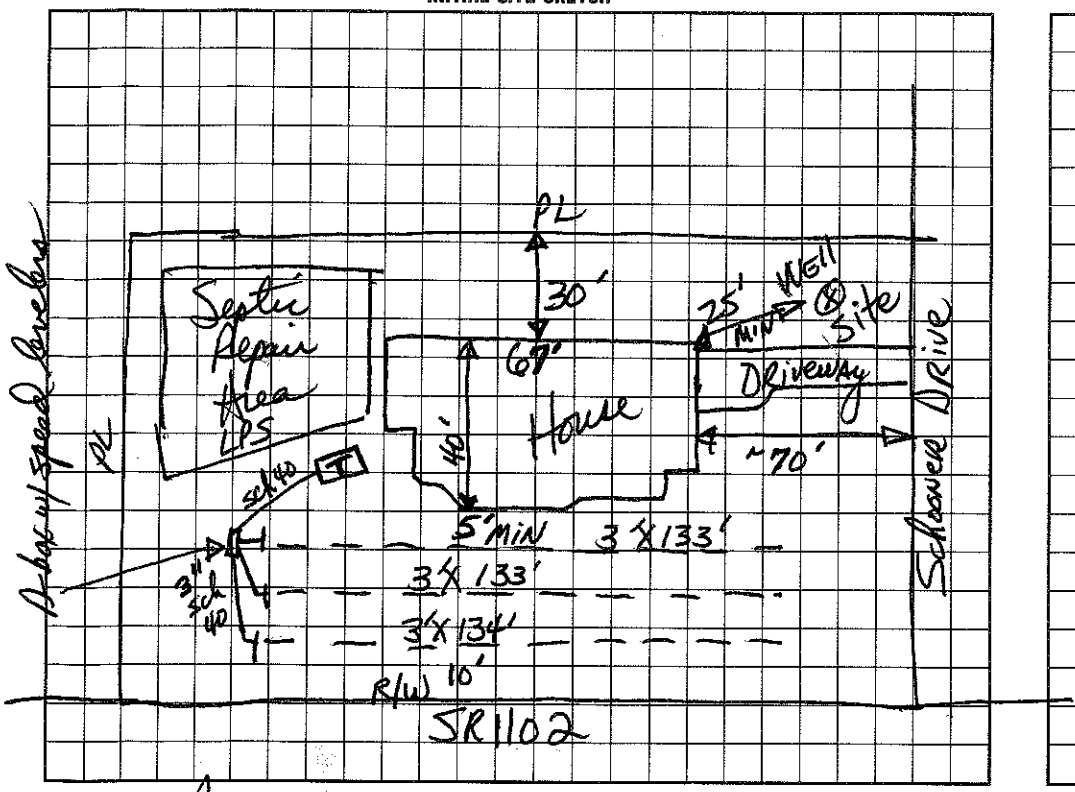

AS BUILT SKETCH

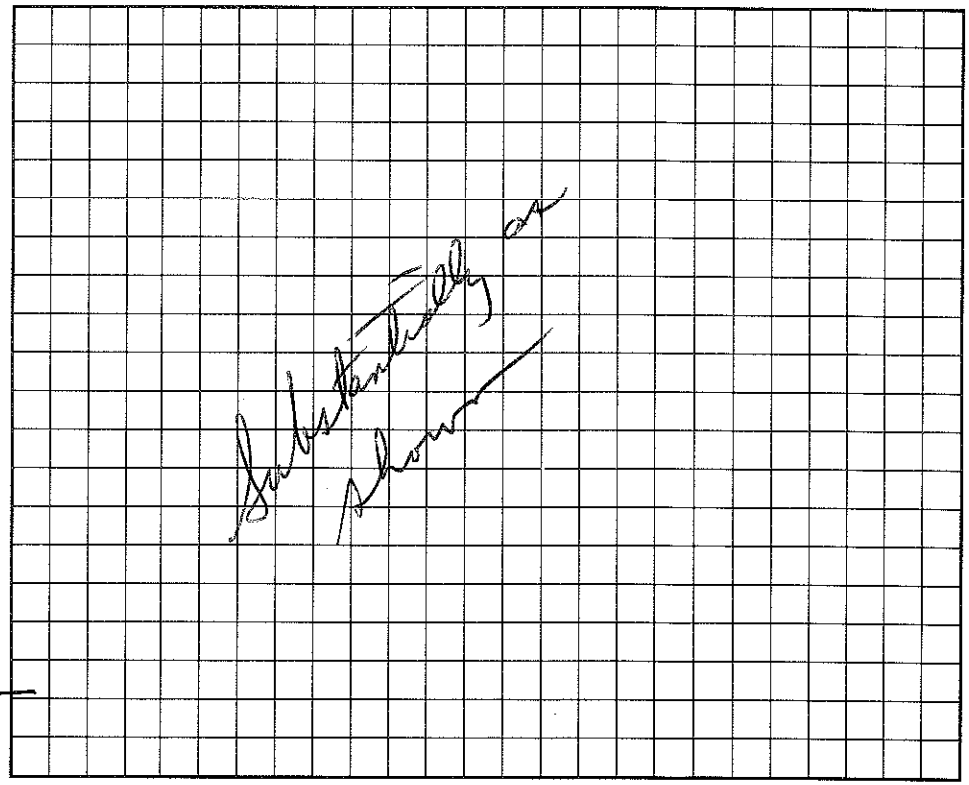

I understand that this permit can be suspended or revoked if any false information is supplied toward securing the permit/any unauthorized changes are made to the site/any unauthorized changes are made in the installation of the system. Improvement Permit is valid for 60 months from date of issuance.

Signed: Paul Hayn

Improvement Permit by: Howard Robinson, RS date 5/16/94

Existing System Inspection by: date

Installed by: Bill Roberson

Certificate of Completion by: Howard Robinson, RS date 10-3-94

Operation Permit by: date

HEALTH DEPT. COPY: WHITE INSPECTION COPY (FINAL): GREEN OWNER COPY (FINAL): YELLOW INSPECTION COPY (INITIAL): PINK OWNER COPY (INITIAL): GOLD