4634695253

IREDELL COUNTY HEALTH DEPARTMENT

STATESVILLE 704-878-5305 MOORESVILLE 704-664-5281

IMPROVEMENT PERMIT / CERTIFICATE OF COMPLETION / OPERATION PERMIT / EXISTING SYSTEM INSPECTION

PROPERTY DESCRIPTION NO. 17566 DATE Dec 16, '93 TAX MAP NO. 2B-2-A-3 Watershed: ☑ Yes ☐ No

OWNER OR CONTRACTOR Larry F. Hamilton Jr. PHONE: Business _____ Home L.N.

ADDRESS PO Box 70 / Mt Mourne 28123

LOCATION 115 S. TR 1102 on Right ~100' before Schooner Dr.

SUBDIVISION Sailors Lair BLOCK / SECTION _____ LOT 3 LOT AREA 100x200' SITE CLASS RS DESIGN FLOW 360gpd L.T.A.R. .3

Septic Tank: 1000 Gallons; STB / 012 TP Date 6-28-94

Pump Tank: _____ Gallons; PT _____ Date _____

Pump Make: _____ Model _____ Serial No. _____

Nitrification Field: No Fields 2 Square Feet 1200 Linear Feet 400

No Lines 2 Trench Width 36" Max Trench Bottom Depth 36" Gravel Depth 12"

☑ New System ☐ Repair System Type: I, II, III, IV, V, VI

System Description: gravity conventional

Repair System Description: PPBPS

Maintenance Agreement Required: ☐ Yes ☑ No

☑ House/Mod. Home No. Bedrooms 3

☐ Mobile Home No. Bathrooms 2

☐ Business No. Employees _____

☐ Other _____


☐ Slab ☑ Crawl Space ☐ Basement w/plumbing ☐ Basement wo/plumbing

Water Supply: ☑ Individual ☐ Community ☐ Public

Comments: Property recorded prior to Jan. 1, 1983. Repair area for septic system is very limited!

Comments:

INITIAL SITE SKETCH

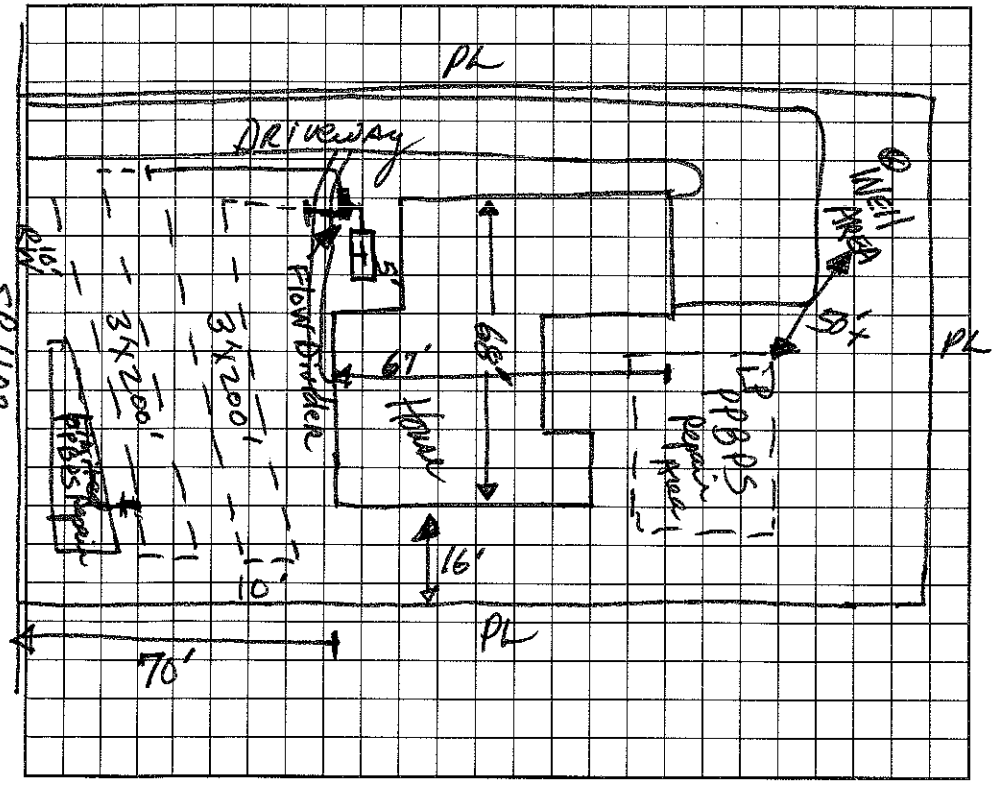

AS BUILT SKETCH

Substantially as shown

I understand that this permit can be suspended or revoked if any false information is supplied toward securing the permit/any unauthorized changes are made to the site/any unauthorized changes are made in the installation of the system. Improvement Permit is valid for 60 months from date of issuance.

Signed: _____

Improvement Permit by: Donald L. Hanson, RS date 12/16/93

Existing System Inspection by: _____ date _____

Installed by: _____

Certificate of Completion by: Donald L. Hanson RS date 9-23-94

Operation Permit by: _____ date _____

HEALTH DEPT. COPY: WHITE INSPECTION COPY (FINAL): GREEN OWNER COPY (FINAL): YELLOW INSPECTION COPY (INITIAL): PINK OWNER COPY (INITIAL): GOLD