IREDELL COUNTY HEALTH DEPARTMENT

Authorization to Construct

STATESVILLE 704-878-5305 MOORESVILLE 704-664-5281

IMPROVEMENT PERMIT / CERTIFICATE OF COMPLETION / OPERATION PERMIT / EXISTING SYSTEM INSPECTION

PROPERTY DESCRIPTION NO. 22429 DATE 12/19/95 TAX MAP NO. 2B 2A 2 4634 69 6257 Watershed: ☒ Yes ☐ No

OWNER OR CONTRACTOR Hamilton Enterprises PHONE: Business _____ Home _____

ADDRESS 838 Langtree Rd. Mooresville, NC

LOCATION Langtree on (R) just before Sanctuary Rd

SUBDIVISION Sanctuary BLOCK / SECTION _____ LOT 2 LOT AREA 100 X 200 SITE CLASS. PS DESIGN FLOW 360 L.T.A.R. .3

Septic Tank: 1000 Gallons; STB 794 Date 5/20/96

Pump Tank: _____ Gallons; PT _____ Date _____

Pump Make: _____ Model _____ Serial No. _____

Nitrification Field: No Fields 1 Square Feet 1200 Linear Feet ~~X~~ 300

No Lines 5 Trench Width 36" Max Trench Bottom Depth 36" Gravel Depth SAND AT

☒ New System ☐ Repair System Type: I, II, III, IV, V, VI

System Description: GRAVITY INFILTRATOR

Repair System Description: ~~Pressure - INFILTRATOR~~

Maintenance Agreement Required: ☐ Yes ☐ No PPBPS

☒ House/Mod. Home ☐ Mobile Home ☐ Business ☐ Other _____

No. Bedrooms ____ No. Bathrooms ____ No. Employees ____


☐ Slab ☒ Crawl Space ☐ Basement w/plumbing ☐ Basement wo/plumbing

Water Supply: ☒ Individual ☐ Community ☐ Public


Comments: ~~X~~ 5 lines @ 60'x3' - 4@ 75' may be used if dimensions, type and location will permit. S/T to be minimum 5' from foundation on all sides. Place sand backfill to top of lowest

Comments:

INITIAL SITE SKETCH

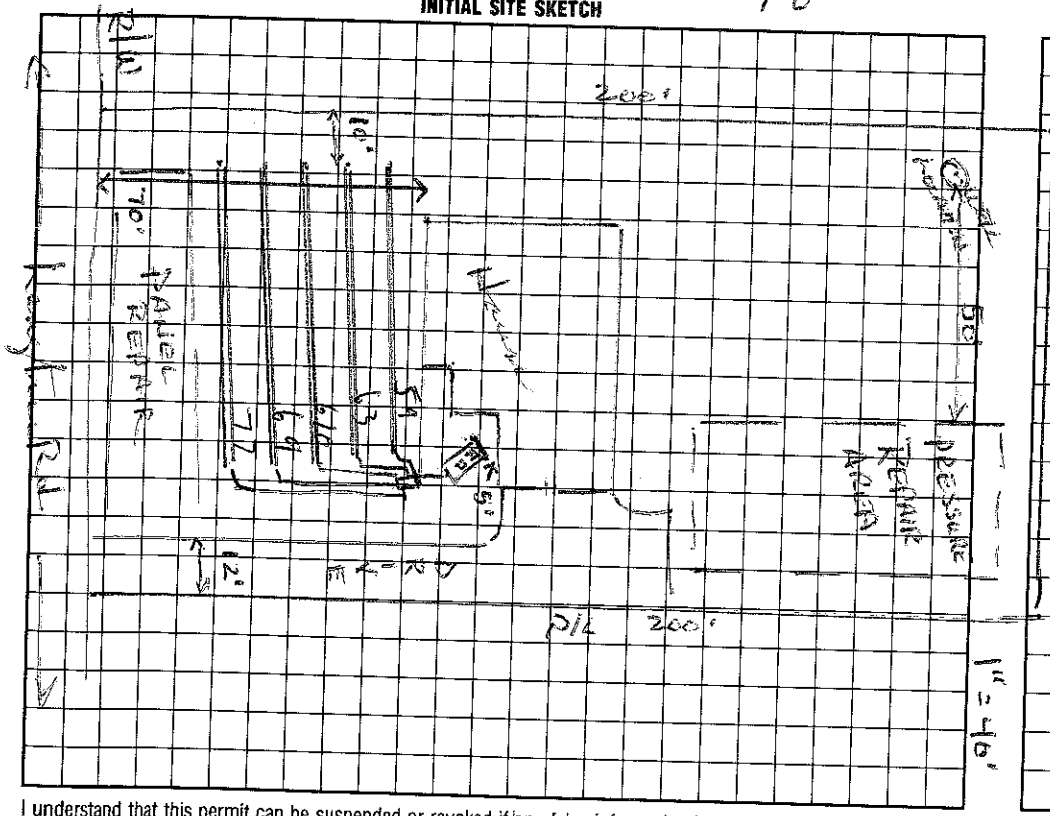

AS BUILT SKETCH

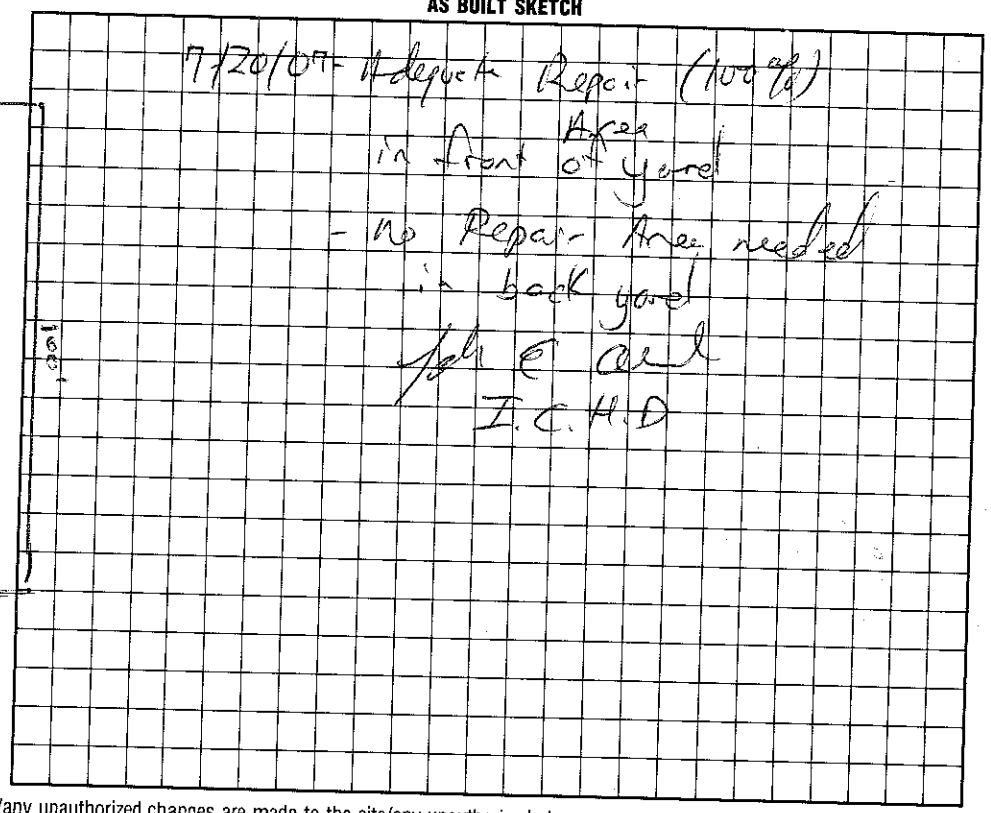

I understand that this permit can be suspended or revoked if any false information is supplied toward securing the permit/any unauthorized changes are made to the site/any unauthorized changes are made in the installation of the system.

Signed: X Larry T. Ferrell

Improvement Permit by: Wesley Sparks R.S. date 12/19/95

~~Existing System Inspection by:~~ Asst. Wesley Sparks R.S. date 12/19/95

Installed by: FJ Ervin

Certificate of Completion by: _____ date _____

Operation Permit by: C. Brad Ferrell EHSI date 7/12/96

HEALTH DEPT. COPY: WHITE INSPECTION COPY (FINAL): GREEN OWNER COPY (FINAL): YELLOW INSPECTION COPY (INITIAL): PINK OWNER COPY (INITIAL): GOLD