4634792511

IREDELL COUNTY HEALTH DEPARTMENT

STATESVILLE 704-878-5305 MOORESVILLE 704-664-5281

IMPROVEMENT PERMIT / CERTIFICATE OF COMPLETION / OPERATION PERMIT / EXISTING SYSTEM INSPECTION

PROPERTY DESCRIPTION NO. _____ DATE Sept. 29, 95 TAX MAP NO. _____ Watershed: ☐ Yes ☐ No

OWNER OR CONTRACTOR Terri Knox PHONE: Business _____ Home _____

ADDRESS Longtree Road

LOCATION Longtree Road on Right just before All Seasons Marina

SUBDIVISION _____ BLOCK / SECTION _____ LOT _____ LOT AREA _____ SITE CLASS. _____ DESIGN FLOW 360 gpd L.T.A.R. .3

Septic Tank: EXISTING Gallons; STB _____ Date _____

Pump Tank: _____ Gallons; PT _____ Date _____

Pump Make: _____ Model _____ Serial No. _____

Nitrification Field: No Fields ____ Square Feet 900 Linear Feet 300

No Lines 4@75' Trench Width _____ Max Trench Bottom Depth _____ Gravel Depth _____

☐ New System ☑ Repair System Type: I, II, III, IV, V, VI

System Description: gravity Infiltrator

Repair System Description: 1 par PVC pipe

Maintenance Agreement Required: ☐ Yes ☑ No

☑ House/Mod. Home No. Bedrooms 3

☐ Mobile Home No. Bathrooms 1-2

☐ Business No. Employees ____

☐ Other _____


☐ Slab ☑ Crawl Space ☐ Basement w/plumbing ☐ Basement wo/plumbing

Water Supply:
☑ Individual EX.
☐ Community
☐ Public

Comments: Lot deeded to existing house - Surrounding acreage containing existing drainfield sold. Disconnect old drainfield; Check tank for tee - use sch 40 to front yard; Set New Box to 4 laterals (Infiltrator)

Comments:

INITIAL SITE SKETCH

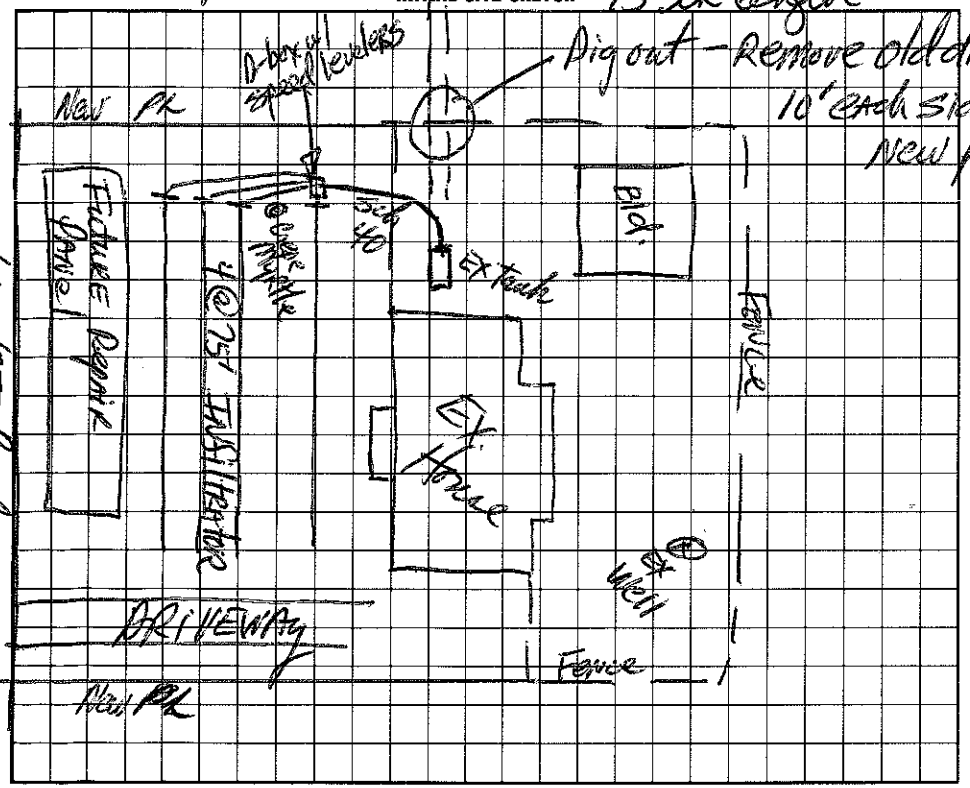

AS BUILT SKETCH

I understand that this permit can be suspended or revoked if any false information is supplied toward securing the permit/any unauthorized changes are made to the site/any unauthorized changes are made in the installation of the system.

Signed: Larry Eaton

Improvement Permit by: Jack R. Hinson, RS date 9-29-95

~~Existing System Inspection by~~ Jack R. Hinson, RS date 10-

Auth to construct

Installed by: Larry Eaton

Certificate of Completion by: Wesley Sparks R.S. date 10/16/95

Operation Permit by: Wesley Sparks R.S. date 10/16/95

HEALTH DEPT. COPY: WHITE INSPECTION COPY (FINAL): GREEN OWNER COPY (FINAL): YELLOW INSPECTION COPY (INITIAL): PINK OWNER COPY (INITIAL): GOLD