IREDELL COUNTY HEALTH DEPARTMENT

STATESVILLE 704-878-5305 MOORESVILLE 704-664-5281

IMPROVEMENT PERMIT / CERTIFICATE OF COMPLETION / OPERATION PERMIT / EXISTING SYSTEM INSPECTION

PROPERTY DESCRIPTION NO. 17526 DATE Dec 30, '93 TAX MAP NO. 2B7A30 Watershed: ☑ Yes ☐ No

OWNER OR CONTRACTOR Joseph & Melissa Mazur PHONE: Business 464-79-7884 Home 537-4547 L.M.

ADDRESS 7521 Riding Trail Road Charlotte 28212

LOCATION Laurtree Road TL Clearwater Lane 2nd lot on left

SUBDIVISION Royal Pointe BLOCK / SECTION ____ LOT 30 LOT AREA 20,600 ft² SITE CLASS. PS per 1956 DESIGN FLOW 360 gpd L.T.A.R. .3 gal/ft²/day

Septic Tank: 1000 Gallons; STB 794 Millinger Date 5-30-94

Pump Tank: ____ Gallons; PT ____ Date ____

Pump Make: ____ Model ____ Serial No. ____

Nitrification Field: No Fields 2 Square Feet ____ Linear Feet 200

No Lines 4 Trench Width 24" Max Trench Bottom Depth 36" Gravel Depth NA

☑ New System ☐ Repair System Type: I, II, III, IV, V, VI

System Description: gravity PPBPS

Repair System Description: gravity LP PPBPS

Maintenance Agreement Required: ☐ Yes ☑ No

☑ House/Mod. Home ☐ Mobile Home ☐ Business ☐ Other

No. Bedrooms 3 No. Bathrooms 3.5 No. Employees ____


☐ Slab ☑ Crawl Space ☐ Basement w/plumbing ☐ Basement wo/plumbing

Water Supply: ☐ Individual ☑ Community ☐ Public


Comments:

Comments: Tank oriented perpendicular to neck of house

INITIAL SITE SKETCH

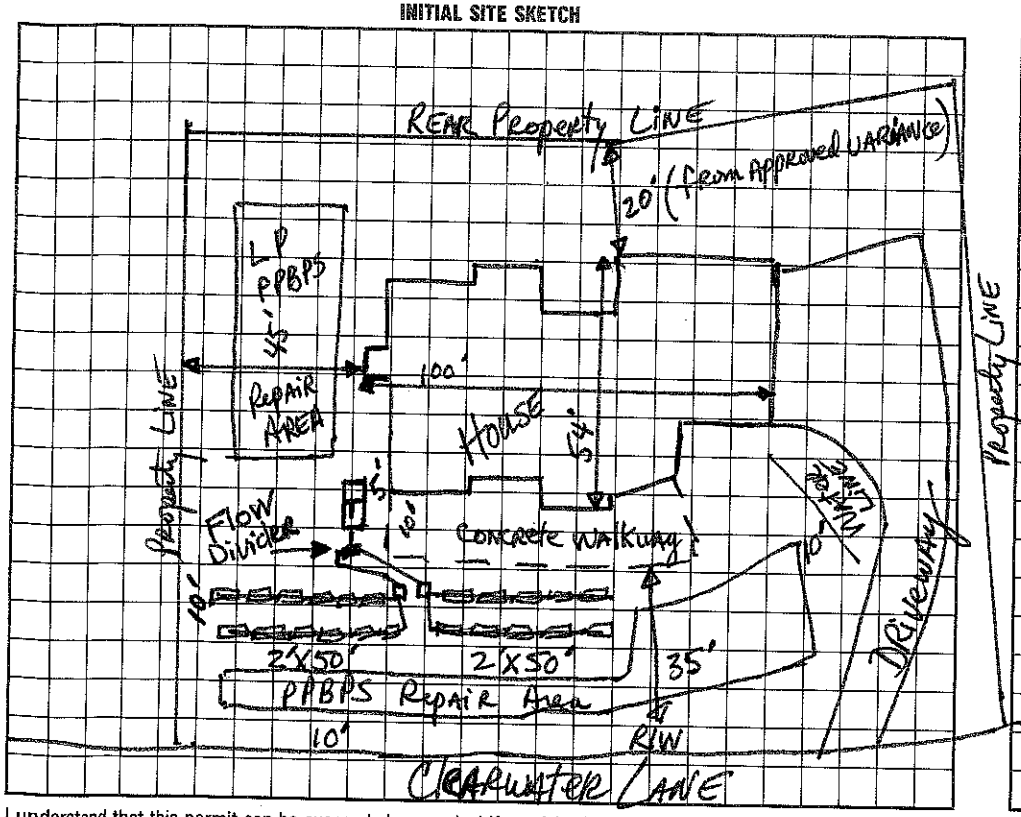

AS BUILT SKETCH

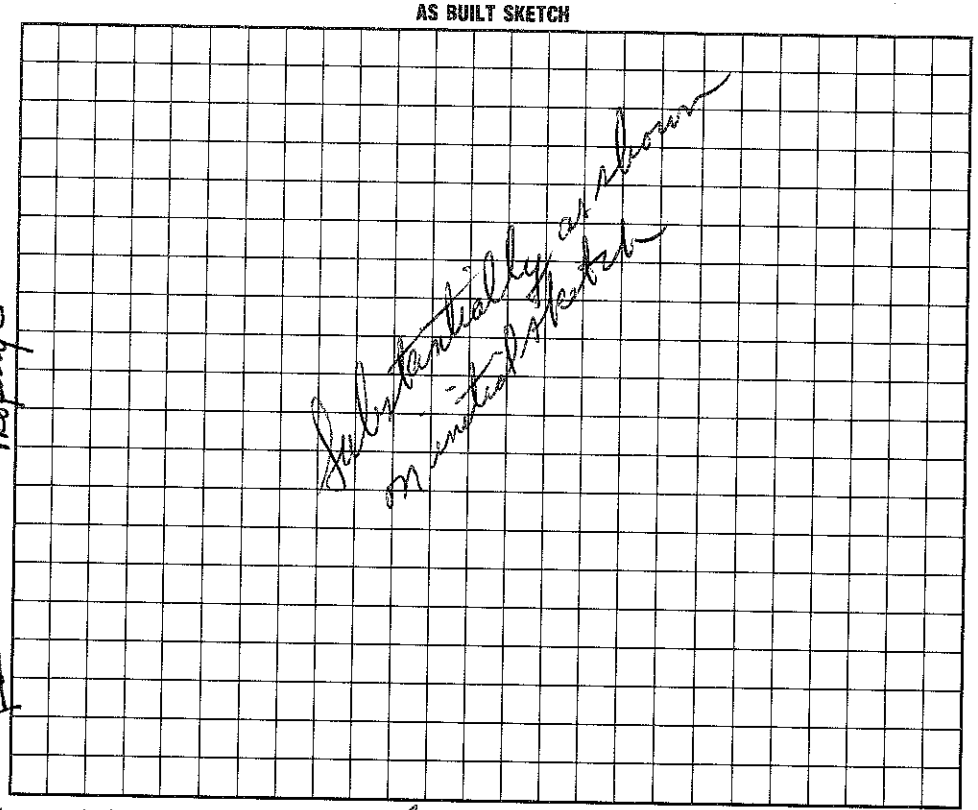

I understand that this permit can be suspended or revoked if any false information is supplied toward securing the permit/any unauthorized changes are made to the site/any unauthorized changes are made in the installation of the system. Improvement Permit is valid for 60 months from date of issuance.

Signed: X Melissa Mazur

Improvement Permit by: David R. Johnson, RS date 12/30/93

Existing System Inspection by: ____ date ____

Installed by: Gary Thompson

Certificate of Completion by: ____ date ____

Operation Permit by: David R. Johnson, RS date 10-5-94

HEALTH DEPT. COPY: WHITE INSPECTION COPY (FINAL): GREEN OWNER COPY (FINAL): YELLOW INSPECTION COPY (INITIAL): PINK OWNER COPY (INITIAL): GOLD