4034-89-0487

IREDELL COUNTY HEALTH DEPARTMENT

STATESVILLE 704-878-5305 MOORESVILLE 704-664-5281

IMPROVEMENT PERMIT / CERTIFICATE OF COMPLETION / OPERATION PERMIT / EXISTING SYSTEM INSPECTION

PROPERTY DESCRIPTION NO. 15699 DATE Sept. 23, '93 TAX MAP NO. 2B7A 26

OWNER OR CONTRACTOR John & Mary Williams PHONE: Business _____ Home _____

ADDRESS _____

LOCATION 1103 T/L Royal Pointe Way on Right

SUBDIVISION Royal Pointe BLOCK / SECTION _____ LOT 26 LOT AREA 20,000 ft²+ SITE CLASS. V5 L.T.A.R. .3

Water Supply: ☐ Individual ☐ Community ☐ Public

Septic Tank: 1000 Gallons; STB 794 Dellinger Date 6-21-93

Pump Tank: _____ Gallons; PT _____ Date _____

Nitrification Field: No. Fields 1 Square Feet 1200 Linear Feet 400+

No. Lines 5 Trench Width 36" Trench Depth 24-36" Gravel Depth 12"+

☑ New System ☐ Repair System Type: I, II, III, IV, V, VI

System Description: gravity conventional

Repair System Description: type: PPBPS

Maintenance Agreement Required: ☐ Yes ☑ No

☐ House/Mod. Home ☐ Mobile Home ☐ Business ☐ Other _____

No. Bedrooms 3 No. Bathrooms 2½ No. Employees _____

☐ Slab ☑ Crawl Space ☐ Basement w/plumbing ☐ Basement wo/plumbing

Garbage Disposal: ☑ Yes ☐ No

Auto. Dishwasher: ☑ Yes ☐ No


Auto. Washing Machine: ☑ Yes ☐ No

Other _____

Comments: Changes in system type approved prior to installation of system based upon # of bedrooms in home.

INITIAL SITE SKETCH

AS BUILT SKETCH

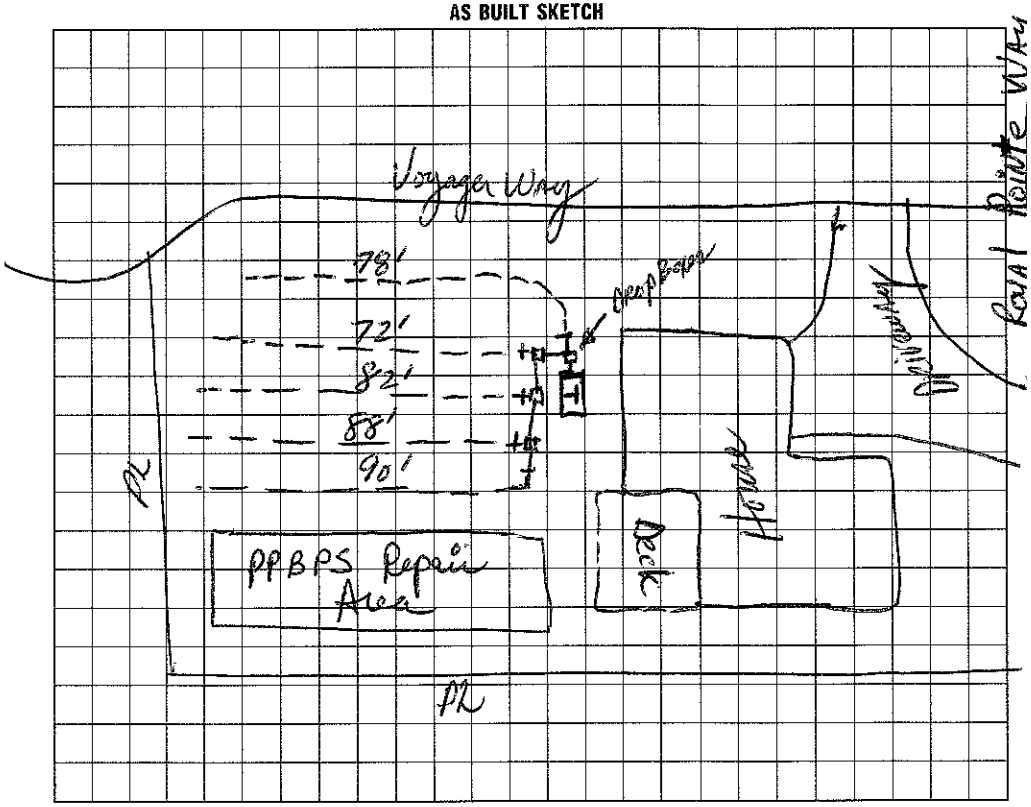

I understand that this permit can be suspended or revoked if any false information is supplied toward securing the permit/any unauthorized changes are made to the site/any unauthorized changes are made in the installation of the system. Improvement Permit is valid for 60 months from date of issuance.

Signed: _____

Improvement Permit by: _____ date _____

Existing System Inspection by: _____ date _____

Installed by: Gary Bradley

Certificate of Completion by: David R. Hunter, RS date 9/23/93

Operation Permit by: _____ date _____

HEALTH DEPT. COPY: WHITE INSPECTION COPY (FINAL): GREEN OWNER COPY (FINAL): YELLOW INSPECTION COPY (INITIAL): PINK OWNER COPY (INITIAL): GOLD