4634-89-0687

IREDELL COUNTY HEALTH DEPARTMENT

STATESVILLE 704-878-5305 MOORESVILLE 704-664-5281

IMPROVEMENT PERMIT / CERTIFICATE OF COMPLETION / OPERATION PERMIT / EXISTING SYSTEM INSPECTION

PROPERTY DESCRIPTION NO. 21435 DATE 4/27/95 TAX MAP NO. 2B 7A 21 Watershed: [X] Yes [ ] No

OWNER OR CONTRACTOR Terry L Taylor PHONE: Business 875-5100 Home

ADDRESS 6906 Crystal Spring Ct. Stanley, NC. 27410

LOCATION Royal Pte. (L) off Langtree (R) on Voyager Way on (R) corner

SUBDIVISION Royal Pte BLOCK / SECTION 1 LOT 21 LOT AREA .469 SITE CLASS. P DESIGN FLOW 360 L.T.A.R. .3

Septic Tank: 1250 Gallons; STB 797 Date 10/9/95

Pump Tank: Gallons; PT Date

Pump Make: Model Serial No.

Nitrification Field: No Fields 1 Square Feet 1200 Linear Feet *300 (400)

No Lines 4 Trench Width 36" Max Trench Bottom Depth 36" Gravel Depth N/A

[X] New System [ ] Repair System Type: I, II, III, IV, V, VI

System Description: INFILTRATOR

Repair System Description: PANEL

Maintenance Agreement Required: [ ] Yes [X] No

[X] House/Mod. Home No. Bedrooms 3

[ ] Mobile Home No. Bathrooms 2

[ ] Business No. Employees

[X] Other GAR. DISP.

[ ] Slab [X] Crawl Space [ ] Basement w/plumbing [ ] Basement wo/plumbing


Water Supply: [ ] Individual [X] Community [ ] Public

Comments:

*25% reduction for Infiltrator use

Comments:

INITIAL SITE SKETCH

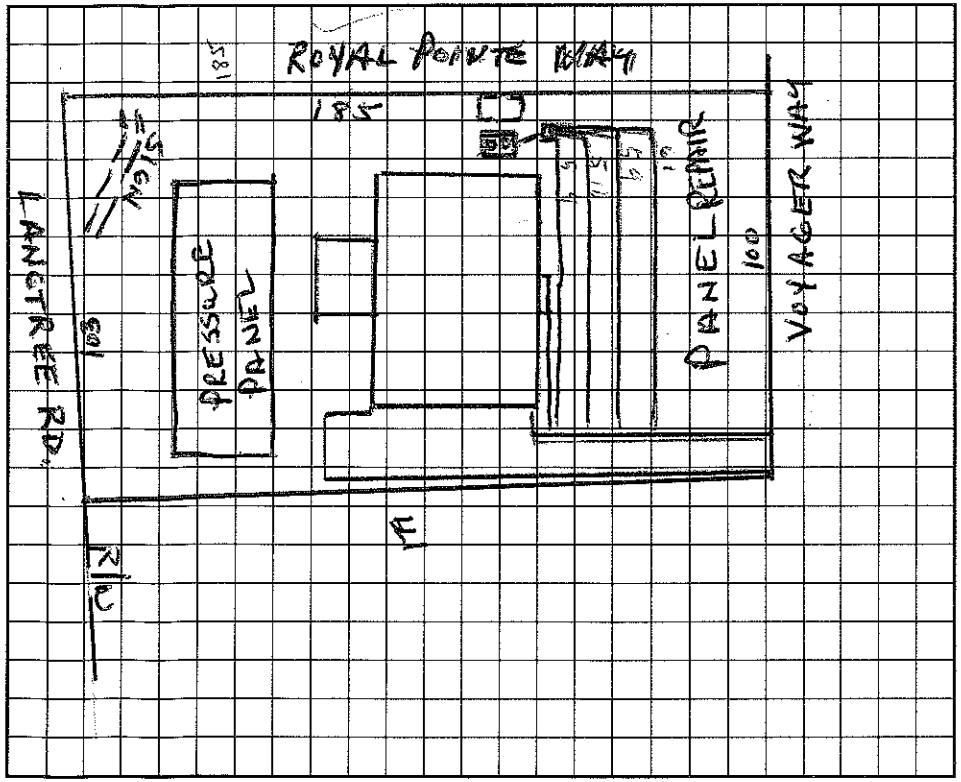

AS BUILT SKETCH

I understand that this permit can be suspended or revoked if any false information is supplied toward securing the permit/any unauthorized changes are made to the site/any unauthorized changes are made in the installation of the system. Improvement Permit is valid for 60 months from date of issuance.

Signed: Paula J Bostic 7-6-95

Improvement Permit by: Wesley Sparks R.S. date 4/27/95

Existing System Inspection by: date

Installed by: R L MacLeod

Certificate of Completion by: Wesley Sparks R.S. date 3/21/96

Operation Permit by: Wesley Sparks R.S. date 3/21/96

HEALTH DEPT. COPY: WHITE INSPECTION COPY (FINAL): GREEN OWNER COPY (FINAL): YELLOW INSPECTION COPY (INITIAL): PINK OWNER COPY (INITIAL): GOLD