Matt Johnson 704 309 5484

IREDELL COUNTY HEALTH DEPARTMENT

STATESVILLE 704-878-5305 MOORESVILLE 704-664-5281

IMPROVEMENT PERMIT / AUTHORIZATION TO CONSTRUCT / OPERATION PERMIT / EXISTING SYSTEM INSPECTION

PERMIT# 132548 PIN# 4634 89 1086 DATE 12/9/05

OWNER OR CONTRACTOR Kenneth Parker PHONE: Business _____ Home _____

ADDRESS 136 Clearwater Ln Mooresville, NC 28117

LOCATION 115 S (R) Langtree (L) Clearwater Ln (R) Lot 136 Clearwater Ln

SUBDIVISION Royal Pointe BLOCK / SECTION _____ LOT 2 LOT AREA .57 acres SITE CLASS. PS DESIGN FLOW 480 gpd L.T.A.R. .3

Septic Tank: 1000 Gallons; STB _____ Date _____

Pump Tank: 1000 Gallons; PT _____ Date _____

Pump Make: _____ Model _____ Serial No. _____

Nitrification Field: No Fields 1 Square Feet ER1320 Linear Feet 220

No Lines 4 Trench Width 24" Max Trench Bottom Depth _____ Gravel Depth N/A

☐ New System ☐ Repair System Type: I, II, III, (IV), V, VI

System Description: LP PPBPS

Repair System Description: same

Maintenance Agreement Required: ☐ Yes ☒ No existing system

☒ House/Mod. Home No. Bedrooms 4

☐ Mobile Home No. Bathrooms _____

☐ Business No. Employees _____

☐ Other _____


☐ Slab ☒ Crawl Space ☐ Basement w/plumbing ☐ Basement wo/plumbing

Water Supply: ☐ Individual ☒ Public ☐ Community


Comments:/Conditions:

Comments:/Conditions:

INITIAL SITE SKETCH

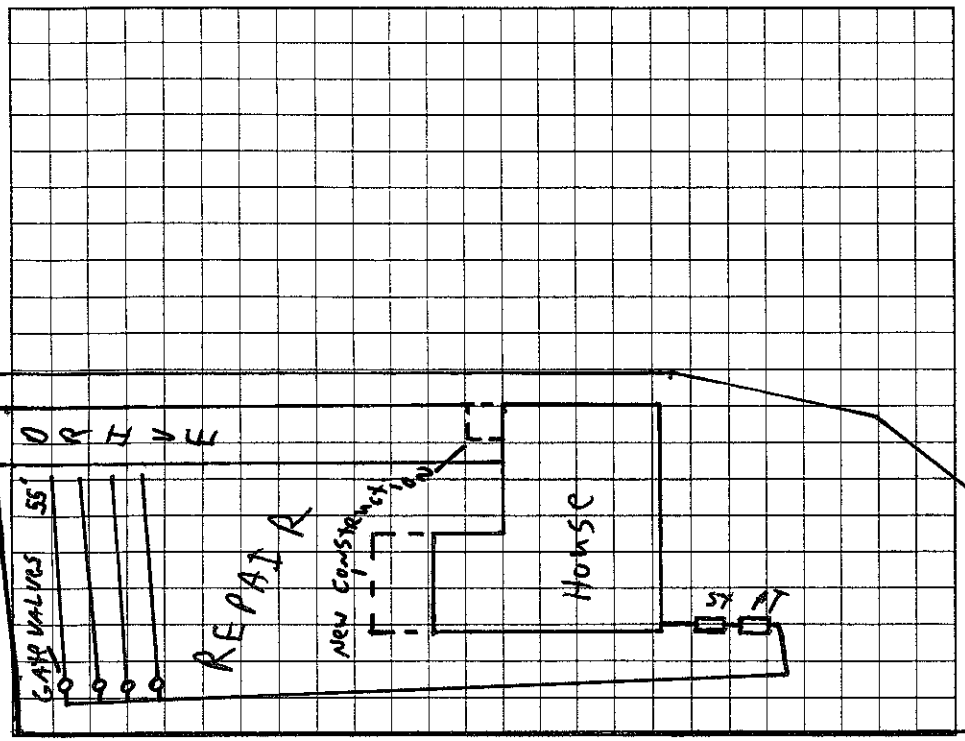

AS BUILT SKETCH

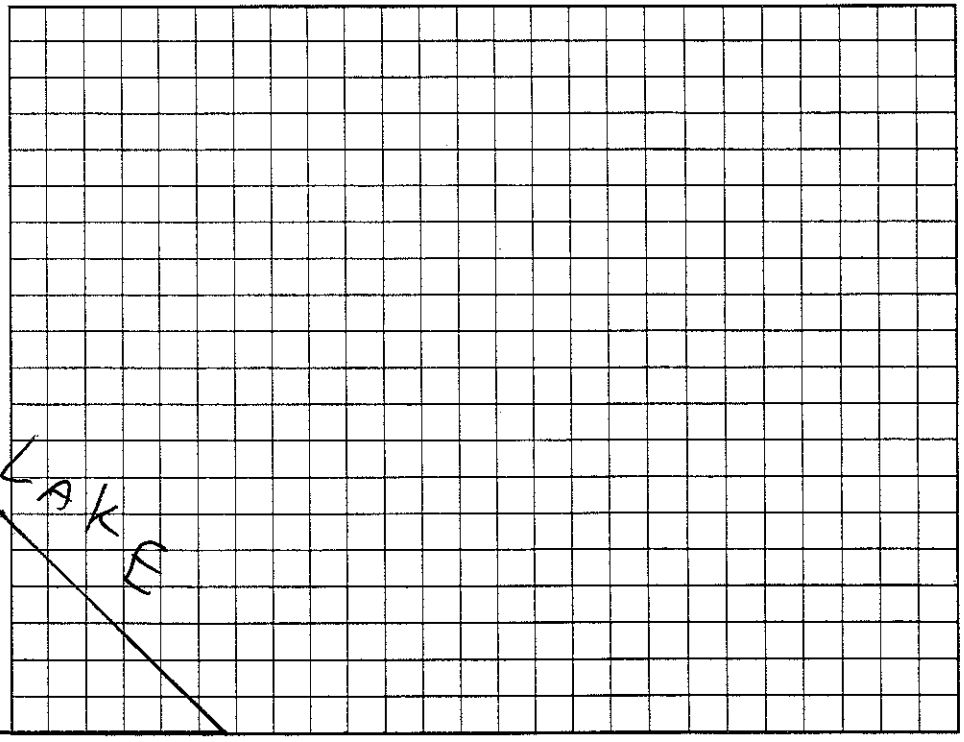

Permit can be suspended or revoked if any false information is supplied toward securing the permit/any unauthorized changes are made to the site/any unauthorized changes are made in the installation of the system. Improvement Permit with plat valid without expiration. Improvement Permit with site plan valid for sixty months. Authorization to Construct is valid for a period equal to that of Improvement Permit – not to exceed sixty months.

Signed: _____ date 3/29/06 Installed by: _____

Improvement Permit by: _____ date _____ Operation Permit by: _____ date _____

Authorization to Construct by: _____ date _____ Existing System Inspection by: _____ date 12/12/05

HEALTH DEPT. COPY: WHITE OWNER COPY (FINAL): YELLOW OWNER COPY (INITIAL): PINK