IREDELL COUNTY HEALTH DEPARTMENT

Statesville Office (704) 878-5305 Mooresville Office (704) 660-3625 PERMIT # 209535

IMPROVEMENT PERMIT / AUTHORIZATION TO CONSTRUCT / OPERATION PERMIT / EXISTING SYSTEM

PIN # 4634-89-1388

APPLICANT: SANDRA BELTRAN APPLICANT ADDRESS: 120 ROYAL POINTE WAY

SITE ADDRESS: SAME PHONE: 704-654-1721 ALT. PHONE:

SITE DIRECTIONS: LANGTREE, TL ROYAL POINTE, ON R

SUBDIVISION: ROYAL POINTE SECTION: 1 LOT # 27 LOT AREA: .49 AC DESIGN FLOW: 360 L.T.A.R.: .3(R)

Septic Tank Ex. 1250 (gal) STB Date

Pump Tank (gal) PT Date

Pump Make Model Serial #

Nitrification Fields # Lines Linear Ft:

Trench Width EXISTING Max. Trench Bottom Depth Gravel Depth

☐ New System ☐ Repair ☐ Expansion System Type: I (II) III IV V VI

System Description: CONVENTIONAL

Repair System Description: PANEL BLOCK

Maintenance Agreement Required: ☐ YES ☒ NO ☒ GRAVITY ☐ PRESSURE

☐ Residence ☒ Other ☐ Slab ☐ Basement w/plumbing

No. Bedrooms 3 No. Persons No. Employees ☒ Crawl Space

Water Supply: ☐ Private ☐ Public ☒ Community


☐ Basement w/o plumbing

Comments / Conditions:

POOL

INITIAL SITE SKETCH

AS BUILT SKETCH

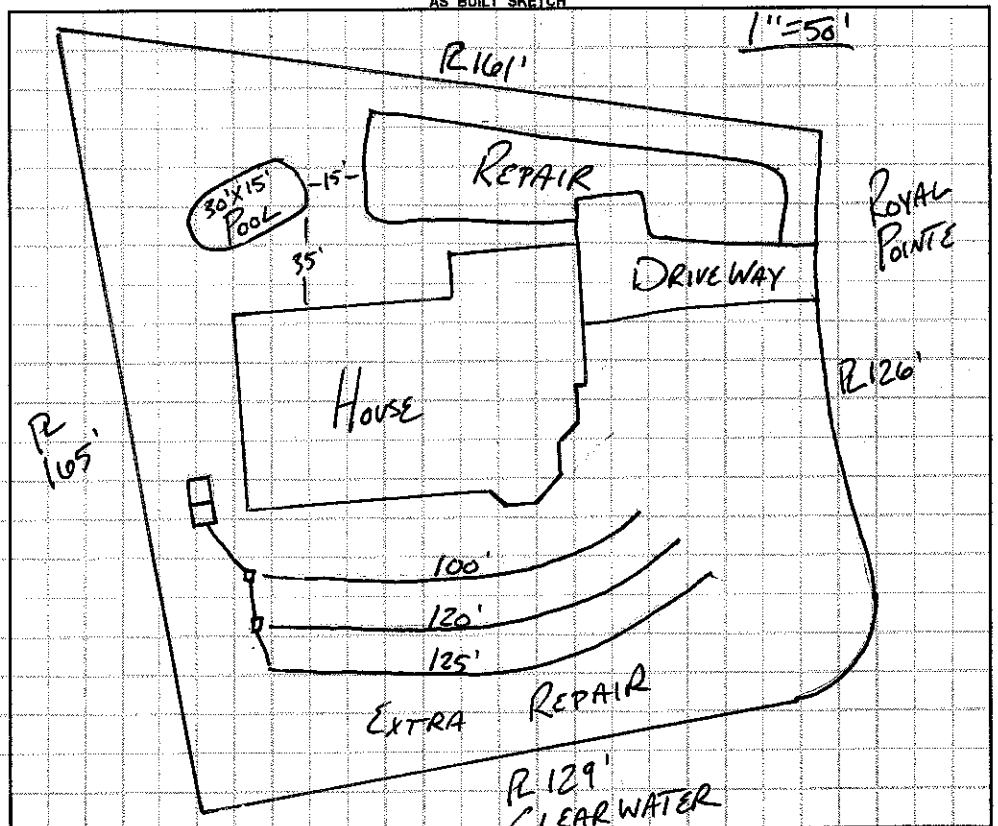

Permit can be suspended or revoked if any false information is supplied toward securing the permit / any unauthorized changes are made to the site / any unauthorized changes are made in the installation of the system. **CONTACT A LOCATOR SERVICE PRIOR TO ANY EXCAVATION**

☐ **IMPROVEMENT PERMIT** *with plat valid without expiration.* ☒ **IMPROVEMENT PERMIT** *with site plan valid for 60 mos.* ☒ **AUTHORIZATION TO CONSTRUCT** *valid for period equal to IMPROVEMENT PERMIT--not to exceed 60 mo.*

Owner / Applicant Signature: Sandra Beltran Date: 7/2/2015 Installed by:

IMPROVEMENT PERMIT by: Date: APPROVED MAY 15 2015 OPERATION PERMIT by: Date: 5-15-15

AUTHORIZATION TO CONSTRUCT by: Date: APPROVED MAY 15 2015 Existing System Inspected by:

Health Dept. Copy - WHITE Applicant (Final Approval) - YELLOW Applicant (Conditional Approval) - PINK