IREDELL COUNTY HEALTH DEPARTMENT

AUTHORIZATION TO CONSTRUCT 4634891917 10-30

STATESVILLE 704-878-5305 MOORESVILLE 704-664-5281

IMPROVEMENT PERMIT / ~~CERTIFICATE OF COMPLETION~~ / OPERATION PERMIT / EXISTING SYSTEM INSPECTION

PROPERTY DESCRIPTION NO. 22055 DATE 6/12/97 TAX MAP NO. 172 B1 A3 Watershed: ☑ Yes ☐ No

OWNER OR CONTRACTOR CALKINS CONSTRUCTION ~~PHONE: Business~~ ~~4634-99-7900~~ Home

ADDRESS

LOCATION LANETREE RD. 3RD LOT ON (R) BEFORE 2ND LAKESHORE DR.

SUBDIVISION LAKEVIEW SHORE BLOCK / SECTION LOT 3 LOT AREA 100X200 SITE CLASS. RS DESIGN FLOW 360 GPD L.T.A.R. .356 GPD/FT²

Septic Tank: 1000 Gallons; STB 794 Date 8/5/97

Pump Tank: Gallons; PT Date

Pump Make: Model Serial No.

Nitrification Field: No Fields 1 Square Feet 1075 Linear Feet 342

No Lines 4 @ 86' Trench Width 36" Max Trench Bottom Depth 32" Gravel Depth 12"

☑ New System ☐ Repair System Type: I, (II), III, IV, V, VI

System Description: GRAVITY CONVENTIONAL

Repair System Description: SOME REPAIR - BEFORE

Maintenance Agreement Required: ☐ Yes ☑ No 1983

☑ House/Mod. Home No. Bedrooms 3

☐ Mobile Home No. Bathrooms 2.5

☐ Business No. Employees

☐ Other


☐ Slab ☑ Crawl Space ☐ Basement w/plumbing ☐ Basement wo/plumbing

Water Supply: ☑ Individual ☐ Community ☐ Public

Comments:

Comments:

INITIAL SITE SKETCH 1"=50'

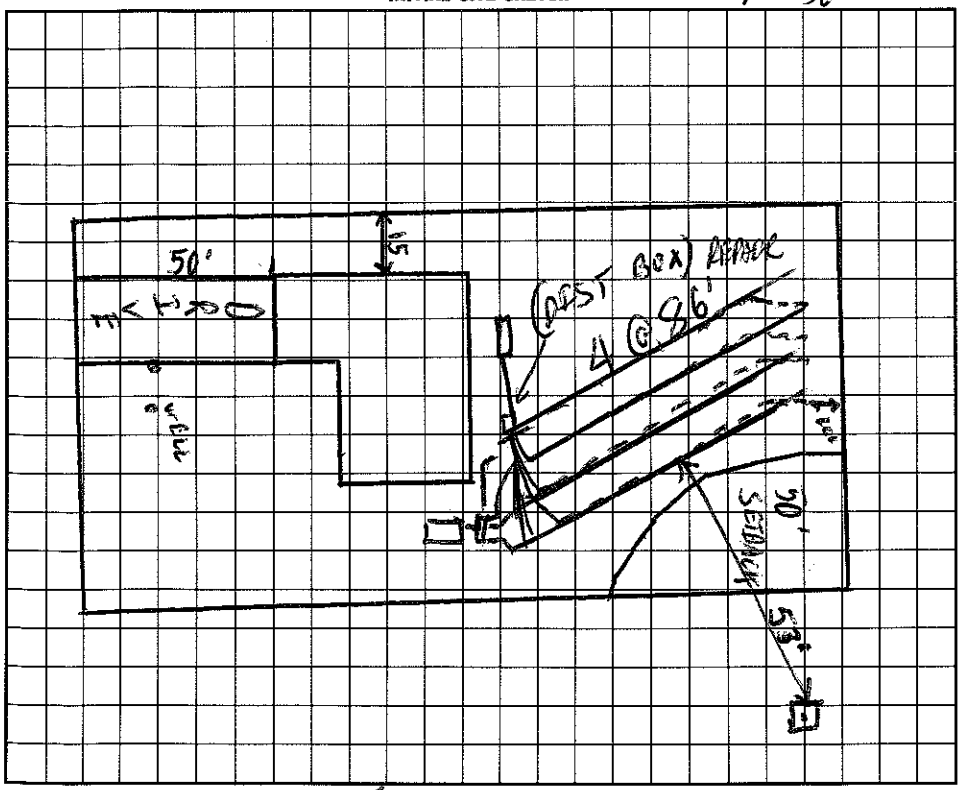

AS BUILT SKETCH

I understand that this permit can be suspended or revoked if any false information is supplied toward securing the permit/any unauthorized changes are made to the site/any unauthorized changes are made in the installation of the system. Improvement Permit is valid for 60 months from date of issuance.

Signed:

Improvement Permit by: date 6/12/97

AUTHORIZATION TO CONSTRUCT Existing System Inspection by: date 6/13/97

Installed by: Wesley Chesterfield

Certificate of Completion by: Wesley Sparks RS. date 10/9/97

Operation Permit by: Wesley Sparks RS. date 10/9/97

HEALTH DEPT. COPY: WHITE INSPECTION COPY (FINAL): GREEN OWNER COPY (FINAL): YELLOW INSPECTION COPY (INITIAL): PINK OWNER COPY (INITIAL): GOLD