IREDELL COUNTY HEALTH DEPARTMENT / Authorization to Construct

STATESVILLE 704-878-5305 MOORESVILLE 704-664-5281

IMPROVEMENT PERMIT / CERTIFICATE OF COMPLETION / OPERATION PERMIT / EXISTING SYSTEM INSPECTION

PROPERTY DESCRIPTION NO. 24403 DATE 8/8/96 TAX MAP NO. 4634 89 3128 Watershed: [X] Yes [ ] No

OWNER OR CONTRACTOR Town Square Investments PHONE: Business 892-7240 Home

ADDRESS PO Box 664 Cornelius, NC 28031

LOCATION Royal Pointe Way, Longtree Rd. TL Royal Pointe on (R) at Clean water Lagoon intersection

SUBDIVISION Royal Pointe BLOCK / SECTION 1 LOT 4 LOT AREA .54AC SITE CLASS. PS DESIGN FLOW 480 L.T.A.R. .3

Septic Tank: 1000 Gallons; STB 794 Date

Pump Tank: 1000 Gallons; PT 29 Date

Pump Make: HYDROMATIC Model SK 50A1 Serial No. 1-97

Nitrification Field: No Fields 1 Square Feet 1600 Linear Feet ±270

No Lines 3 Trench Width 24-30" Max Trench Bottom Depth 30" Gravel Depth SAND

[X] New System [ ] Repair System Type: I, II, (III), IV, V, VI

System Description: ~~Pres Manifold~~ - 16" PANELS

Repair System Description: Same

Maintenance Agreement Required: [ ] Yes [ ] No

[X] House/Mod. Home No. Bedrooms 4

[ ] Mobile Home No. Bathrooms 3.5

[ ] Business No. Employees

[ ] Other


[ ] Slab [X] Crawl Space [ ] Basement w/plumbing [ ] Basement wo/plumbing

Water Supply: [ ] Individual [X] Community [ ] Public

Comments:

Comments:
62 - 7-7.5" drawdown

INITIAL SITE SKETCH

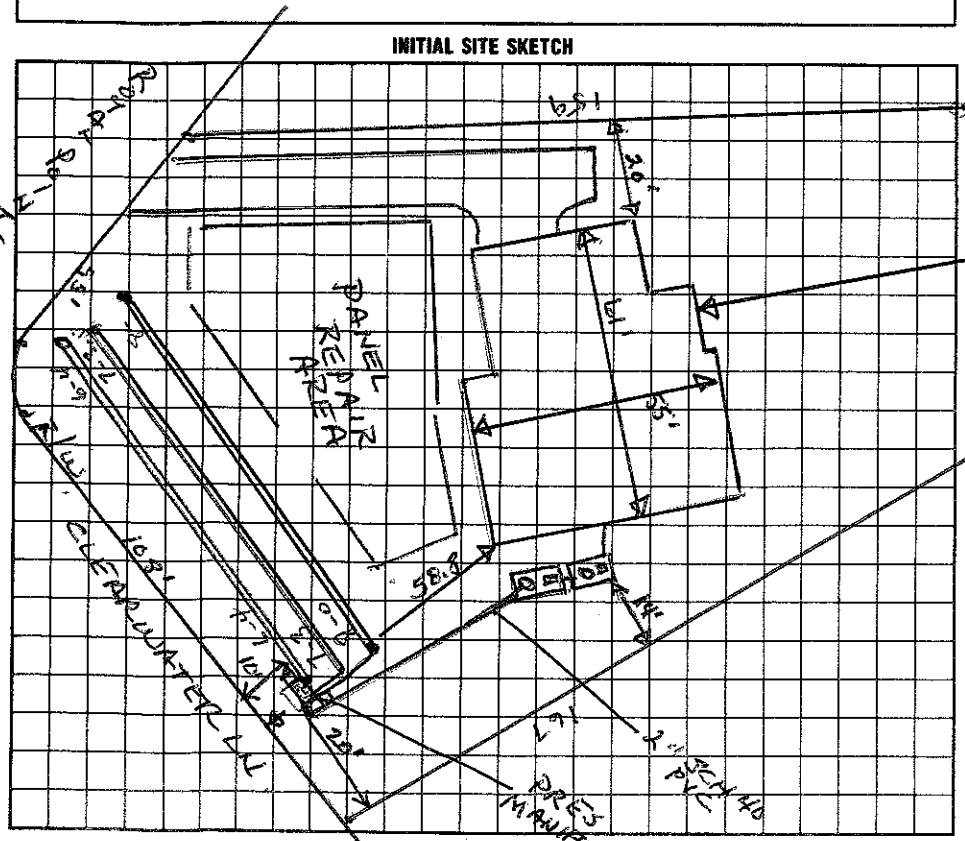

AS BUILT SKETCH

I understand that this permit can be suspended or revoked if any false information is supplied toward securing the permit/any unauthorized changes are made to the site/any unauthorized changes are made in the installation of the system.

Authorization to Construct valid indefinitely.

Signed: [signature]

Improvement Permit by: Wesley Sparks RS. date 8/8/96

Authorization to Construct Wesley Sparks RS date 8/8/96

Installed by: Bob Mayhew

Certificate of Completion by: Wesley Sparks RS. date 3/11/97

Operation Permit by: Wesley Sparks RS. date 3/11/97

HEALTH DEPT. COPY: WHITE INSPECTION COPY (FINAL): GREEN OWNER COPY (FINAL): YELLOW INSPECTION COPY (INITIAL): PINK OWNER COPY (INITIAL): GOLD