4634-89-3738

IREDELL COUNTY HEALTH DEPARTMENT

STATESVILLE 704-878-5305 MOORESVILLE 704-664-5281

IMPROVEMENT PERMIT / CERTIFICATE OF COMPLETION / OPERATION PERMIT / EXISTING SYSTEM INSPECTION

PROPERTY DESCRIPTION NO. 19947 DATE 1/20/95 TAX MAP NO. 2B 7A 20 Watershed: ☑ Yes ☐ No

OWNER OR CONTRACTOR Bruce + Denise Moore PHONE: Business _____ Home 892-9909

ADDRESS 308 Northwest Drive Davidson, NC 28036

LOCATION Langtree Rd (L) into Royal Pointe (L) on Topsail Place to 2nd lot on (L)

SUBDIVISION Royal Pointe BLOCK / SECTION _____ LOT 20 LOT AREA ~.5 Ac SITE CLASS. P DESIGN FLOW 480 L.T.A.R. .3

Septic Tank: 1000 Gallons; STB 794 Date 4/16/95

Pump Tank: _____ Gallons; PT _____ Date _____

Pump Make: _____ Model _____ Serial No. _____

Nitrification Field: No Fields 1 Square Feet 1600 Linear Feet 270*

No Lines 4 Trench Width 24" Max Trench Bottom Depth 36" Gravel Depth 6" STONE

☑ New System ☐ Repair System Type: I, II, (III), IV, V, VI

System Description: GRAVITY PANEL

Repair System Description: PRESSURE - PANEL

Maintenance Agreement Required: ☐ Yes ☑ No

☑ House/Mod. Home No. Bedrooms 4

☐ Mobile Home No. Bathrooms 3

☐ Business No. Employees ____

☐ Other _____


☑ Slab ☐ Crawl Space ☐ Basement w/plumbing ☐ Basement wo/plumbing

Water Supply: ☐ Individual ☑ Community ☐ Public

Comments: Tight

Comments: Installed as shown on Imp. Permit

INITIAL SITE SKETCH

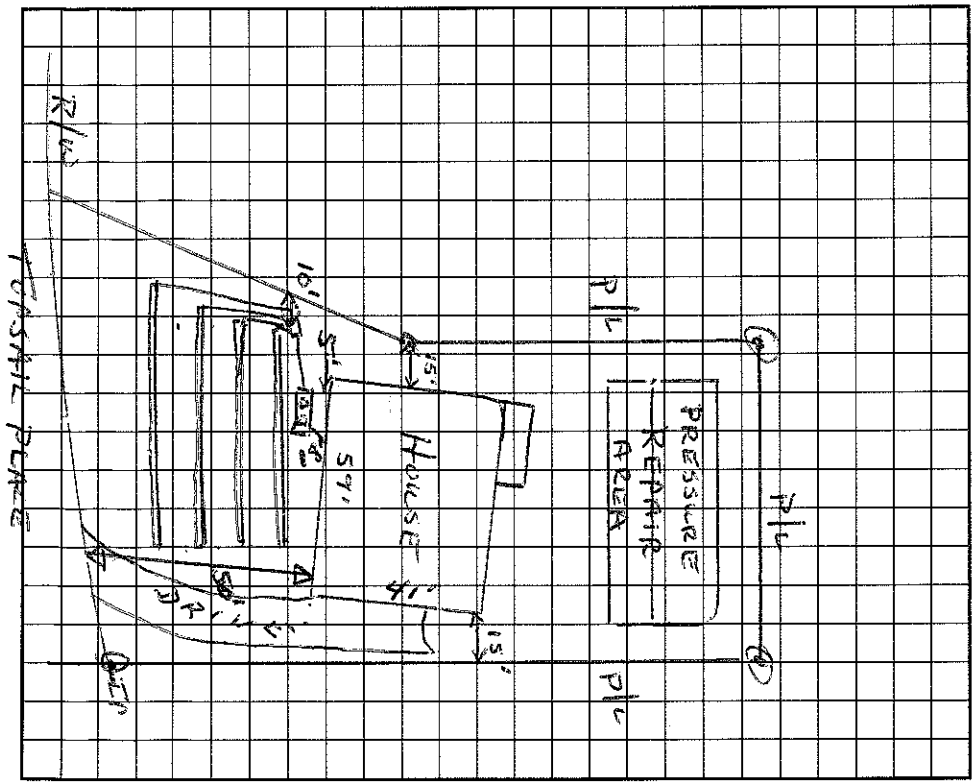

AS BUILT SKETCH

I understand that this permit can be suspended or revoked if any false information is supplied toward securing the permit/any unauthorized changes are made to the site/any unauthorized changes are made in the installation of the system. Improvement Permit is valid for 60 months from date of issuance.

Signed: x Bruce E. Moore

Improvement Permit by: Wesley Sparks R.S. date 1/20/95

Existing System Inspection by: _____ date _____

Installed by: F J Erwin

Certificate of Completion by: Wesley Sparks R.S. date 9/15/95

Operation Permit by: _____ date _____

HEALTH DEPT. COPY: WHITE INSPECTION COPY (FINAL): GREEN OWNER COPY (FINAL): YELLOW INSPECTION COPY (INITIAL): PINK OWNER COPY (INITIAL): GOLD