IREDELL COUNTY HEALTH DEPARTMENT

STATESVILLE 704-878-5305 MOORESVILLE 704-664-5281

IMPROVEMENT PERMIT / CERTIFICATE OF COMPLETION / OPERATION PERMIT / EXISTING SYSTEM INSPECTION

PROPERTY DESCRIPTION NO. 19242 DATE Aug. 26, '94 TAX MAP NO. 2B7A19 4634-89-4808 Watershed: ☐ Yes ☐ No

OWNER OR CONTRACTOR Lakeview Homes PHONE: Business 872-9196 Home CIN

ADDRESS 20464 A Chadwell Ct. Dr. Davidson 28036

LOCATION 115 S IR Langtree TL Royal Pt Way TL To pail at end on left - in cul-d-sac

SUBDIVISION Royal Pointe BLOCK / SECTION ____ LOT 19 LOT AREA 22,000 ft² SITE CLASS. 15 per 1996 DESIGN FLOW 450 gpd L.T.A.R. .3

Septic Tank: 1000 Gallons; STB 79-1 Date 9/26/94

Pump Tank: 1000 Gallons; PT 27 Date 10/9/94

Pump Make: ____ Model ____ Serial No. ____

Nitrification Field: No Fields 1 Square Feet ____ Linear Feet 280

No Lines 4 Trench Width 24" Max Trench Bottom Depth 36" Gravel Depth ____

☑ New System ☐ Repair System Type: I, II, III, IV, V, VI

System Description: LPPBPS

Repair System Description: Same

Maintenance Agreement Required: ☑ Yes ☐ No

☑ House/Mod. Home No. Bedrooms 4

☐ Mobile Home No. Bathrooms 2½

☐ Business No. Employees ____

☐ Other ____


☐ Slab ☑ Crawl Space ☐ Basement w/plumbing ☐ Basement wo/plumbing

Water Supply: ☐ Individual ☑ Community ☐ Public

Comments: Laterals to follow contour. ONE 3/16" hole per panel. 62 panels total.

Comments: Plainfield, Pump Tanks, Alarm OK'd - 11/30/94 Need Cert of Contract, Alarm wired, Need 44 Box

INITIAL SITE SKETCH

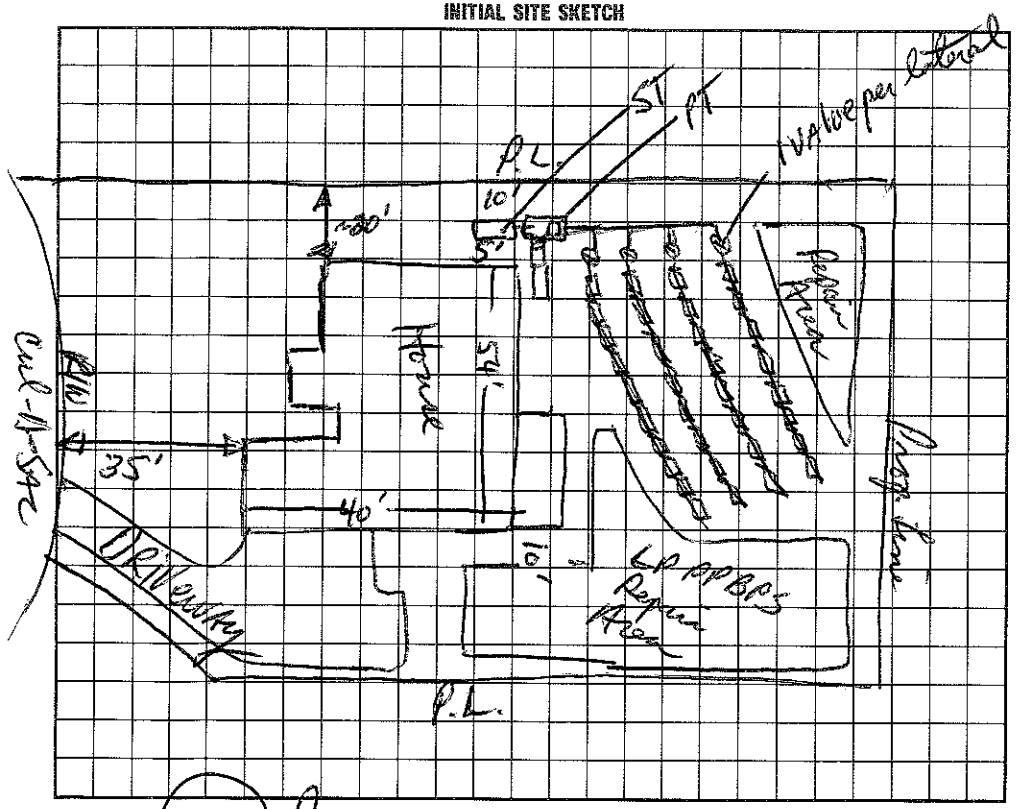

AS BUILT SKETCH

Installed as shown.

I understand that this permit can be suspended or revoked if any false information is supplied toward securing the permit/any unauthorized changes are made to the site/any unauthorized changes are made in the installation of the system. Improvement Permit is valid for 60 months from date of issuance.

Signed: Kathy Dellinger

Improvement Permit by: Thomas L. Hinson, RS date 8/26/94

Existing System Inspection by: ____ date ____

Installed by: F J Ervin

Certificate of Completion by: Wesley Sparks R.S. date 1/9/95

Operation Permit by: Wesley Sparks R.S. date 1/9/95

HEALTH DEPT. COPY: WHITE INSPECTION COPY (FINAL): GREEN OWNER COPY (FINAL): YELLOW INSPECTION COPY (INITIAL): PINK OWNER COPY (INITIAL): GOLD