IREDELL COUNTY HEALTH DEPARTMENT

STATESVILLE 704-878-5305 MOORESVILLE 704-664-5281

IMPROVEMENT PERMIT / CERTIFICATE OF COMPLETION / OPERATION PERMIT / EXISTING SYSTEM INSPECTION

PROPERTY DESCRIPTION NO. 14802 DATE 10-29-92 TAX MAP NO. 2837A12 4634895335 Watershed: ☐ Yes ☐ No

OWNER OR CONTRACTOR LATITUDE 41 INC PHONE: Business 704 892-1484 Home

ADDRESS PO BOX 1085 DAVIDSON NC 28036

LOCATION 115 SOUTH, TURN RIGHT 1102, TURN LEFT ROYAL POINTE WAY, 4TH LOT ON LEFT FROM 1102 (LANGTREE RD)

SUBDIVISION ROYAL POINTE BLOCK / SECTION LOT 12 LOT AREA 20,000 SITE CLASS. P DESIGN FLOW L.T.A.R.

Septic Tank: 1000 Gallons; STB (Dellinger) Date 10-11-92

Pump Tank: 1000 Gallons; PT (") Date 10-11-92

Pump Make: GOULD Model Serial No.

Nitrification Field: No Fields 1 Square Feet 900 Linear Feet 300

No Lines 3 Trench Width 36" Max Trench Bottom Depth 12" Gravel Depth 12"

☑ New System ☐ Repair System Type: I, II, III, IV, V, VI

System Description: gravity conventional c

Repair System Description: pressure PPBPS

Maintenance Agreement Required: ☐ Yes ☐ No

☐ Slab ☑ Crawl Space ☐ Basement w/plumbing ☐ Basement wo/plumbing

☑ House/Mod. Home No. Bedrooms 3

☐ Mobile Home No. Bathrooms 2½

☐ Business No. Employees

☐ Other


Water Supply: ☐ Individual ☑ Community ☐ Public

Comments:

Comments: AT GRADE INSTALLATION W/ 6" OF clay (com FILL. DO NOT GRADE OVER SYSTEM. FILL AND SURFACE WATER INTERCEPT DITCH INSTALLED W/O NOTIFYING DEPT. FOR INSPECTION. DITCH PLACED OVER DISTAL END OF LATERALS.

INITIAL SITE SKETCH

AS BUILT SKETCH

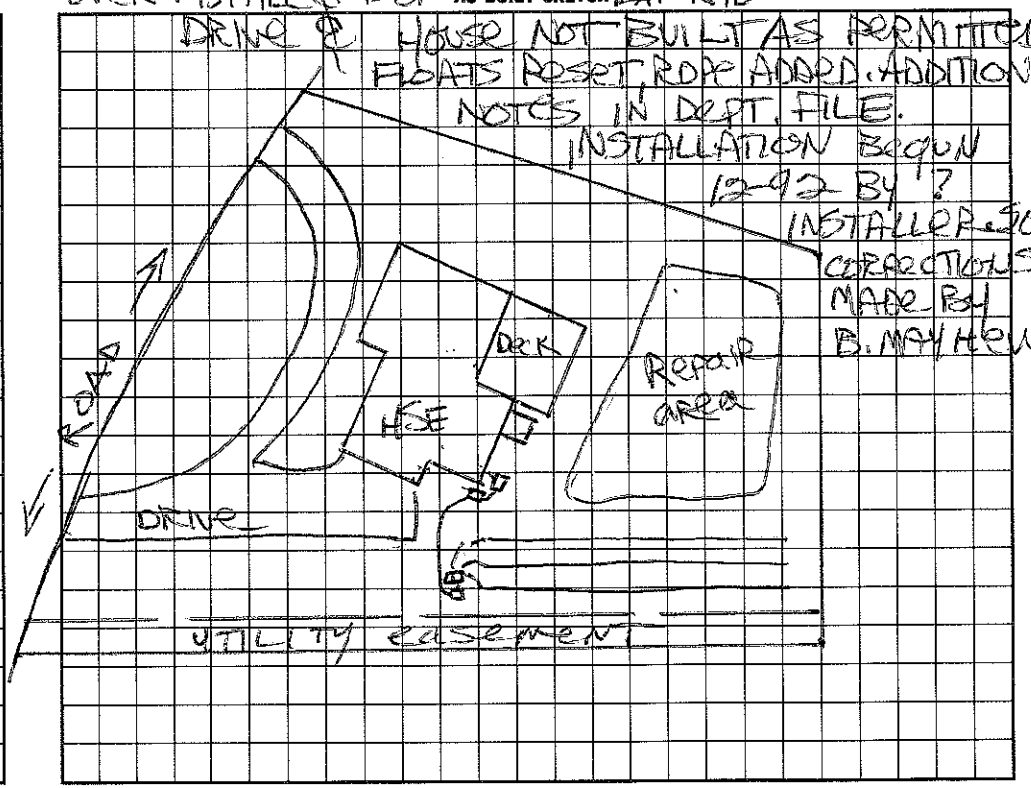

I understand that this permit can be suspended or revoked if any false information is supplied toward securing the permit/any unauthorized changes are made to the site/any unauthorized changes are made in the installation of the system. Improvement Permit is valid for 60 months from date of issuance.

Signed:

Improvement Permit by: date

Existing System Inspection by: date

Installation Completed by: Bobby Mayhew

Installed by:

Certificate of Completion by: Andrea Lemon / DAN HANSON date 10-13-93

Operation Permit by: date

HEALTH DEPT. COPY: WHITE INSPECTION COPY (FINAL): GREEN OWNER COPY (FINAL): YELLOW INSPECTION COPY (INITIAL): PINK OWNER COPY (INITIAL): GOLD