IREDELL COUNTY HEALTH DEPARTMENT

STATESVILLE 704-878-5305 MOORESVILLE 704-664-5281

IMPROVEMENT PERMIT / CERTIFICATE OF COMPLETION / OPERATION PERMIT / EXISTING SYSTEM INSPECTION

PROPERTY DESCRIPTION NO. 13856 DATE July 16, '93 4634-89-5701 TAX MAP NO. 2B7A17

OWNER OR CONTRACTOR Lakeview Homes PHONE: Business _____ Home _____

ADDRESS _____

LOCATION 115 S, TR 1102 TL Royal Pointe TL Topsail Pl. At End ON Right

SUBDIVISION Royal Pointe BLOCK / SECTION / LOT 17 LOT AREA ~20,000 ft² SITE CLASS. PS per 1956 L.T.A.R. .3 gal/ft²/day

Water Supply: ☐ Individual ☑ Community ☐ Public

Septic Tank: 1500 Gallons; STB 780 (ACP) Date 3-24-93

Pump Tank: _____ Gallons; PT _____ Date _____

Nitrification Field: No Fields 2 Square Feet _____ Linear Feet 200

No Lines 4 Trench Width 24" Trench Depth 36-42" Gravel Depth NA

☑ New System ☐ Repair System Type: I, II, III, IV, V, VI

System Description: gravity PPBPS

Repair System Description: SAME

Maintenance Agreement Required: ☐ Yes ☑ No

☑ House/Mod. Home No. Bedrooms 3 Garbage Disposal: ☑ Yes ☐ No

☐ Mobile Home No. Bathrooms 2½ Auto. Dishwasher: ☐ Yes ☐ No

☐ Business No. Employees _____ Auto. Washing Machine: ☑ Yes ☐ No


☐ Other _____ Other _____

☐ Slab ☑ Crawl Space ☐ Basement w/plumbing ☐ Basement wo/plumbing

Comments Trnk set approx at grade, however upper laterals still have approx 1½' cover. No unsuitable soils noted at this depth.

INITIAL SITE SKETCH

AS BUILT SKETCH

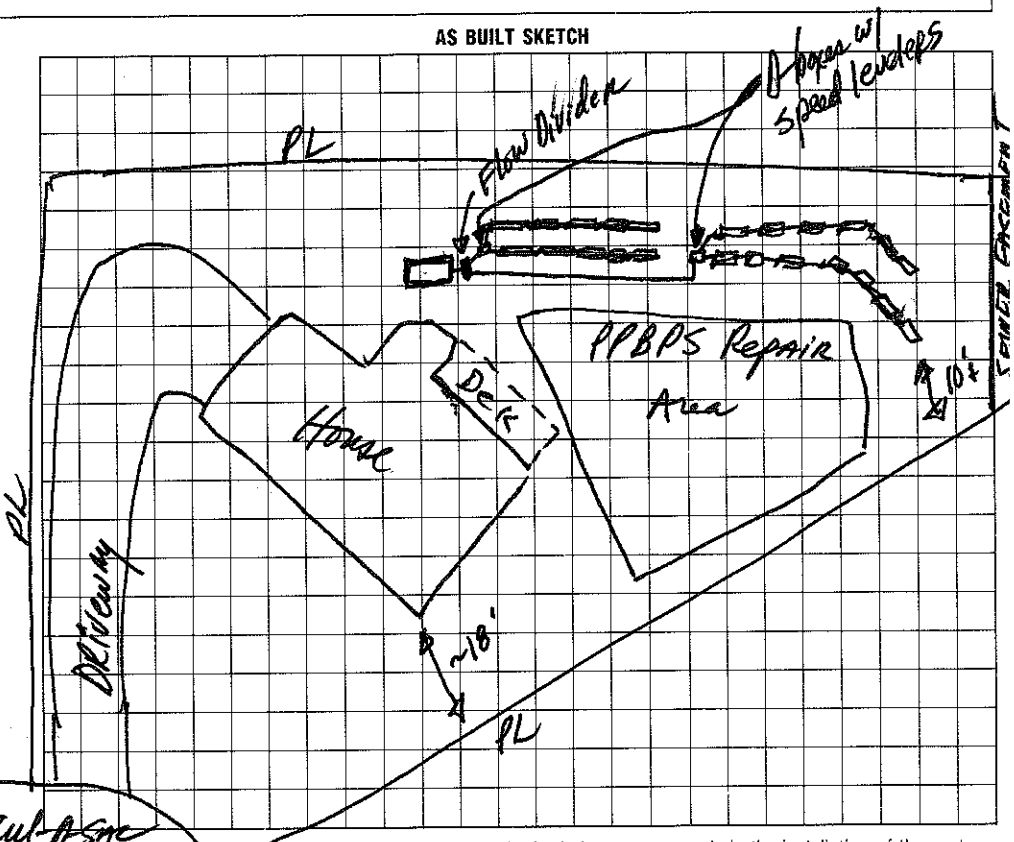

I understand that this permit can be suspended or revoked if any false information is supplied toward securing the permit/any unauthorized changes are made to the site/any unauthorized changes are made in the installation of the system. Improvement Permit is valid for 60 months from date of issuance.

Signed: _____

Improvement Permit by: _____ date _____

Existing System Inspection by: _____ date _____

Installed by: F.J. Ekvin

Certificate of Completion by: _____ date _____

Operation Permit by: _____ date 7/16/93

HEALTH DEPT. COPY: WHITE INSPECTION COPY (FINAL): GREEN OWNER COPY (FINAL): YELLOW INSPECTION COPY (INITIAL): PINK OWNER COPY (INITIAL): GOLD