4634-89-5901

IREDELL COUNTY HEALTH DEPARTMENT

STATESVILLE 704-878-5305 MOORESVILLE 704-664-5281

IMPROVEMENT PERMIT / CERTIFICATE OF COMPLETION / OPERATION PERMIT / EXISTING SYSTEM INSPECTION

PROPERTY DESCRIPTION NO. 1924 DATE Aug. 26, '94 TAX MAP NO. 2B7H 18 Watershed: ☑ Yes ☐ No L.N.

OWNER OR CONTRACTOR Lakeview Homes PHONE: Business 892-9196 Home

ADDRESS 20464 A Chartwell Ctr. Dr. Davidson, N.C. 28036

LOCATION 115 S. off Langtree Rd. TL Royal Pt Way TL Topsail Place at end in Cul-A-Sac

SUBDIVISION Royal Pointe BLOCK / SECTION LOT 18 LOT AREA ±20,000 ft² SITE CLASS PS per 1951 DESIGN FLOW 360 gpd L.T.A.R. .13

Septic Tank: 1000 Gallons; STB 744 Date 9/27/94

Pump Tank: Gallons; PT Date

Pump Make: Model Serial No.

Nitrification Field: No Fields 1 Square Feet Linear Feet 200

No Lines 3 Trench Width 24" Max Trench Bottom Depth 36" Gravel Depth

☑ New System ☐ Repair System Type: I, II, III, IV, V, VI

System Description: gravity PP PBPS

Repair System Description: LP PPBPS

Maintenance Agreement Required: ☐ Yes ☑ No

☑ House/Mod. Home No. Bedrooms 3

☐ Mobile Home No. Bathrooms 2½

☐ Business No. Employees

☐ Other

☐ Slab ☑ Crawl Space ☐ Basement w/plumbing ☐ Basement wo/plumbing


Water Supply: ☐ Individual ☑ Community ☐ Public

Comments:

Comments:

Installed essentially as drawn

INITIAL SITE SKETCH

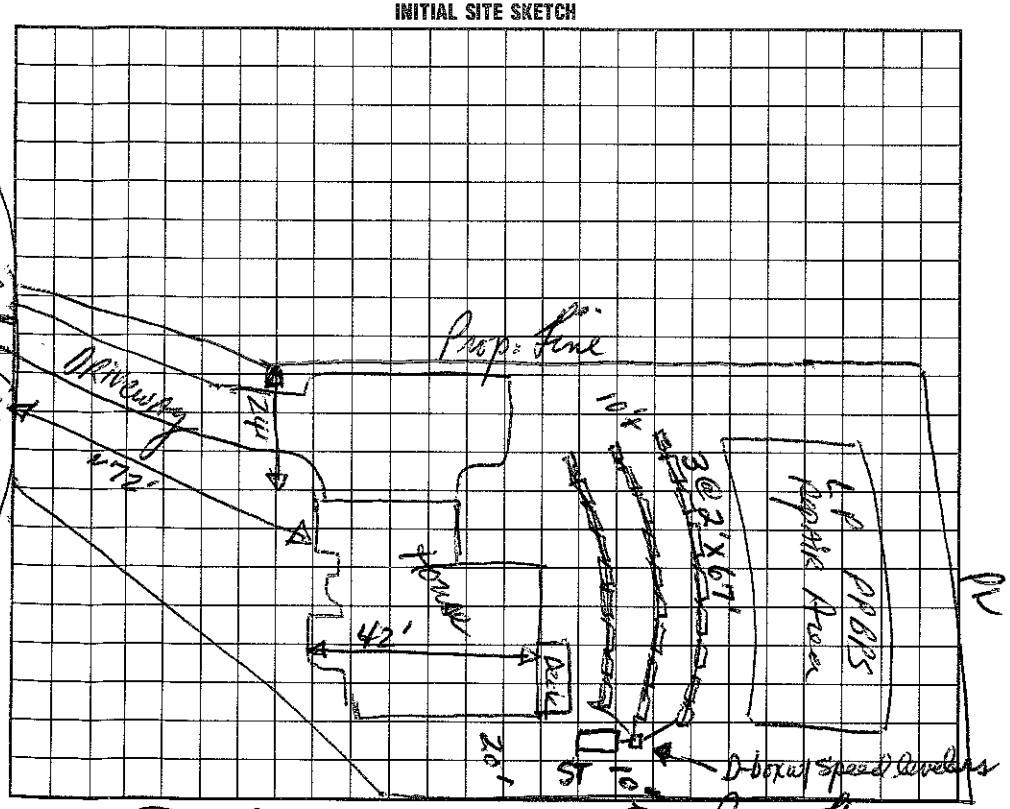

AS BUILT SKETCH

I understand that this permit can be suspended or revoked if any false information is supplied towards securing the permit/any unauthorized changes are made to the site/any unauthorized changes are made in the installation of the system. Improvement Permit is valid for 60 months from date of issuance.

Signed: Kathy Dallenbach

Improvement Permit by: Jane D. Hinson, RS date 8/26/94

Existing System Inspection by: date

Installed by: F. I. Ervin

Certificate of Completion by: Wesley Sparks RS date 11/22/94

Operation Permit by: date

HEALTH DEPT. COPY: WHITE INSPECTION COPY (FINAL): GREEN OWNER COPY (FINAL): YELLOW INSPECTION COPY (INITIAL): PINK OWNER COPY (INITIAL): GOLD