IREDELL COUNTY HEALTH DEPARTMENT

STATESVILLE 704-878-5305 MOORESVILLE 704-664-5281

IMPROVEMENT PERMIT / AUTHORIZATION TO CONSTRUCT / OPERATION PERMIT / EXISTING SYSTEM INSPECTION

PERMIT# REPAIR PIN# 4634-89-6041 DATE 4/2/04

OWNER OR CONTRACTOR Jonathan Zulman PHONE: Business 799-8866 Home 895-4983

ADDRESS 142 Royal Point Way Mooresville, NC. 28117

LOCATION 115-2 S TR Longtree Rd. TL Royal Point Way # 142 on (R) before cul-de-sac.

SUBDIVISION Royal Point BLOCK / SECTION _____ LOT 8 LOT AREA ~1 Ac SITE CLASS PS DESIGN FLOW 360 L.T.A.R. .3

Septic Tank: EXIST. 1250 Gallons; STB _____ Date _____

Pump Tank: EXIST 1250 Gallons; PT _____ Date _____

Pump Make: _____ Model _____ Serial No. _____

Nitrification Field: No Fields 1 Square Feet 600 Linear Feet 200

No Lines 4@50' Trench Width 2-3' Max Trench Bottom Depth 3' Gravel Depth No

☐ New System ☒ Repair System Type: I, II, III, IV, V, VI

System Description: _____

Repair System Description: Pres Dosed - 16" PPBPS

Maintenance Agreement Required: ☐ Yes ☐ No

☐ House/Mod. Home No. Bedrooms 4

☐ Mobile Home No. Bathrooms _____

☐ Business No. Employees _____

☐ Other _____


☐ Slab ☐ Crawl Space ☐ Basement w/plumbing ☐ Basement wo/plumbing

Water Supply: ☐ Individual ☐ Public ☐ Community


Comments:/Conditions: 3/16" hole per panel - turned up at 10:00 - 2:00 position, drain hole per lateral; Valving as shown here, GATE Valves ONLY

Comments:/Conditions: 11/10 9,88 > 46 Pounds - 5 lbs in 2' Pressure Test

INITIAL SITE SKETCH

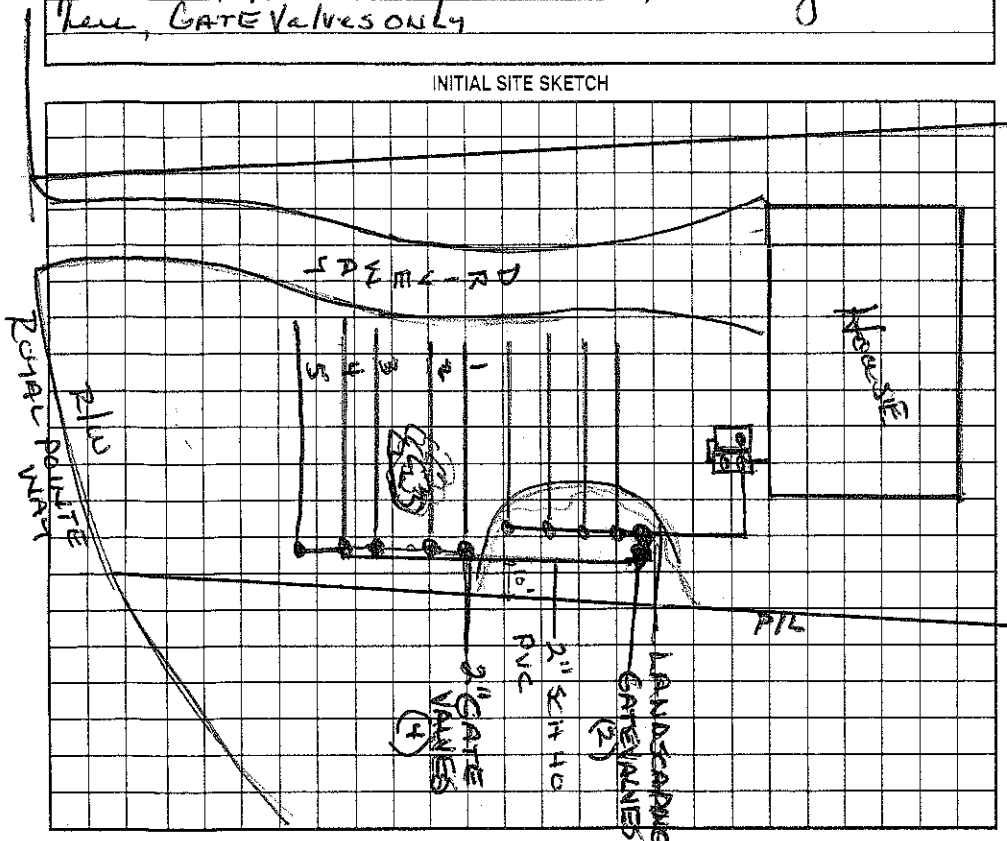

AS BUILT SKETCH

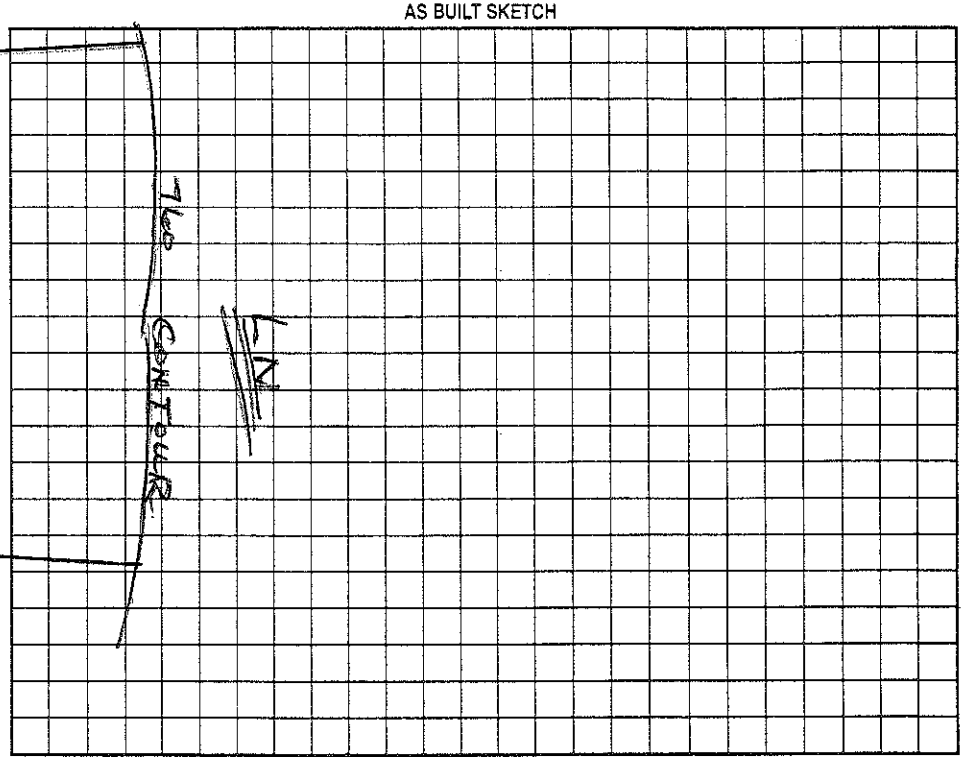

Permit can be suspended or revoked if any false information is supplied toward securing the permit/any unauthorized changes are made to the site/any unauthorized changes are made in the installation of the system. Improvement Permit with plat valid without expiration. Improvement Permit with site plan valid for sixty months. Authorization to Construct is valid for a period equal to that of Improvement Permit -- not to exceed sixty months.

Signed: X _____ date _____

Improvement Permit by: Wesley Sparks RS. date 4/2/04

Authorization to Construct by: Wesley Sparks RS. date 4/2/04

Installed by: Attey Bentley

Operation Permit by: Wesley Sparks RS. date 7/28/06

Existing System Inspection by: _____ date _____

HEALTH DEPT. COPY: WHITE OWNER COPY (FINAL): YELLOW OWNER COPY (INITIAL): PINK

IREDELL COUNTY HEALTH DEPARTMENT

STATESVILLE 704-878-5305 MOORESVILLE 704-664-5281

IMPROVEMENT PERMIT / CERTIFICATE OF COMPLETION / OPERATION PERMIT / EXISTING SYSTEM INSPECTION

PROPERTY DESCRIPTION NO. 13947 DATE 6/7/93 760 TAX MAP NO. 4634-89-6041 2B 7AB

OWNER OR CONTRACTOR JUDY ROBERTSON PHONE: Business Home 314-0947

ADDRESS ROYAL POINTE WAY MOORESVILLE

LOCATION ROYAL POINTE TL OFF LANGTREE RD ON JUST BEFORE 50' CULDESAC

SUBDIVISION ROYAL POINTE BLOCK / SECTION LOT 8 LOT AREA ± 1.04AC SITE CLASS. P L.T.A.R. .25-.3

Water Supply: ☑ Individual ☐ Community ☐ Public

Septic Tank: 1250 Gallons; STB Date

Pump Tank: 1250 Gallons; PT Date

Nitrification Field: No Fields 1 Square Feet Linear Feet 200

No Lines 4 Trench Width 2' Trench Depth 3 Gravel Depth

☑ New System ☐ Repair System Type: I II IV V VI

System Description: PPB P3 16

Repair System Description: PP P55

Maintenance Agreement Required: ☑ Yes ☐ No

☑ House/Mod. Home No. Bedrooms 3

☐ Mobile Home No. Bathrooms 3

☐ Business No. Employees

☐ Other

☐ Slab ☑ Crawl Space ☐ Basement w/plumbing ☐ Basement wo/plumbing

Garbage Disposal: ☑ Yes ☐ No

Auto. Dishwasher: ☑ Yes ☐ No

Auto. Washing Machine: ☑ Yes ☐ No


Other

Comments

HOUSE

INITIAL SITE SKETCH

AS BUILT SKETCH

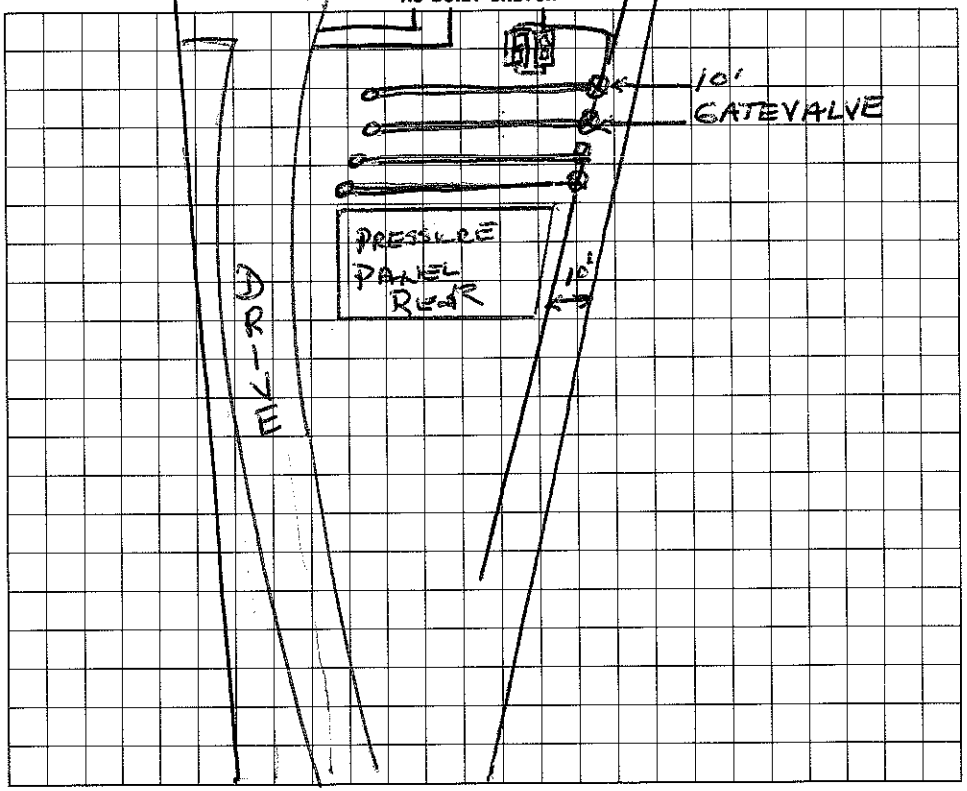

I understand that this permit can be suspended or revoked if any false information is supplied toward securing the permit/any unauthorized changes are made to the site/any unauthorized changes are made in the installation of the system. Improvement Permit is valid for 60 months from date of issuance.

Signed:

Improvement Permit by: date

Existing System Inspection by: date

Installed by: CM KNIGHT CO.

Certificate of Completion by: AWS date 6/10/93

Operation Permit by: Wesley Sparks RS. date 6/10/93

HEALTH DEPT. COPY: WHITE INSPECTION COPY (FINAL): GREEN OWNER COPY (FINAL): YELLOW INSPECTION COPY (INITIAL): PINK OWNER COPY (INITIAL): GOLD