IREDELL COUNTY HEALTH DEPARTMENT

STATESVILLE 704-878-5305 MOORESVILLE 704-664-5281

IMPROVEMENT PERMIT / AUTHORIZATION TO CONSTRUCT / OPERATION PERMIT / EXISTING SYSTEM INSPECTION

PERMIT# 080701 PIN# 4634 89 9783 DATE 6/3/99

OWNER OR CONTRACTOR Augusta Homes PHONE: Business 892-7795 Home

ADDRESS 18525 Statesville Rd D-02

LOCATION Langtree Rd. TL 2ND Knoblick TR Kings Crest Dr. to 5th lot on (L)

SUBDIVISION KINGS LANDING BLOCK / SECTION LOT 35 LOT AREA .69 SITE CLASS. PS DESIGN FLOW 480 L.T.A.R. .3

Septic Tank: 1000 Gallons; STB 332 Date 5/2/00

Pump Tank: 1000 Gallons; PT 283 Date 5/6/00

Pump Make: MYERS Model ME-503-21 Serial No. 1100

Nitrification Field: No Fields 1 Square Feet 799 Linear Feet 266

No Lines 4 Trench Width 36" Max Trench Bottom Depth 36" Gravel Depth SAND

☒ New System ☐ Repair System Type: I, II, III, (IV) V, VI

System Description: Plus 16" PANEL BLOCK

Repair System Description: SAME

Maintenance Agreement Required: ☒ Yes ☐ No

☒ House/Mod. Home No. Bedrooms 4

☐ Mobile Home No. Bathrooms 4

☐ Business No. Employees

☐ Other

☐ Slab ☐ Crawl Space ☒ Basement w/plumbing ☐ Basement wo/plumbing


Water Supply: ☐ Individual ☐ Public ☒ Community

Comments:/Conditions: TIGHT - No changes without written approval of I.C.H.D.


92392

Comments:/Conditions:

INITIAL SITE SKETCH

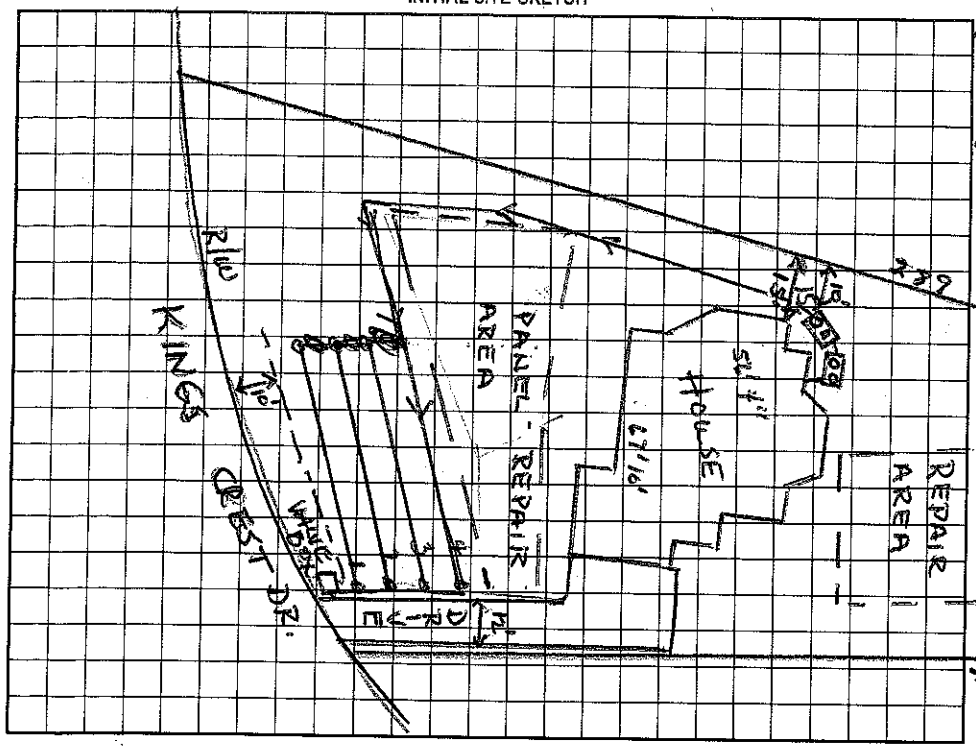

AS BUILT SKETCH

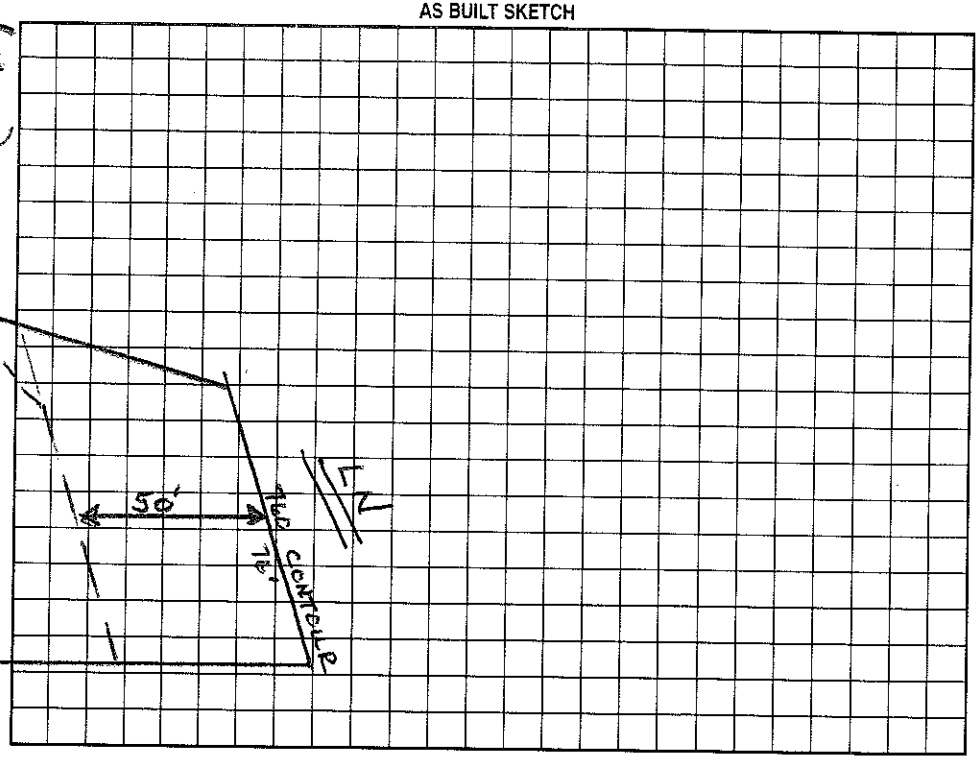

Permit can be suspended or revoked if any false information is supplied toward securing the permit/any unauthorized changes are made to the site/any unauthorized changes are made in the installation of the system. Improvement Permit with plat valid without expiration. Improvement Permit with site plan valid for sixty months. Authorization to Construct is valid for a period equal to that of Improvement Permit – not to exceed sixty months.

Signed: [signature] date 6/17/99

Improvement Permit by: Wesley Sparks RS. date 6/3/99

Authorization to Construct by: Wesley Sparks RS. date 6/3/99

Installed by: R+H Inc.

Operation Permit by: Wesley Sparks RS. date 7/11/00

Existing System Inspection by: date

HEALTH DEPT. COPY: WHITE OWNER COPY (FINAL): YELLOW OWNER COPY (INITIAL): PINK