IREDELL COUNTY HEALTH DEPARTMENT

STATESVILLE 704-878-5305 375.00 Paid MOORESVILLE 704-664-5281

IMPROVEMENT PERMIT / AUTHORIZATION TO CONSTRUCT / OPERATION PERMIT / EXISTING SYSTEM INSPECTION

PERMIT# 12510 PIN# 4634 89 9893 DATE 5/9/05

OWNER OR CONTRACTOR David Nelson PHONE: Business Home 704 895 4194

ADDRESS 108 Castle Bay Ct. Mooresville, NC. 28117

LOCATION Langston Rd. TR Kingsland TR Kings Crest Ct., #34 on (L)

SUBDIVISION Kings Landing BLOCK / SECTION LOT 34 LOT AREA 1.5 ac SITE CLASS. PS DESIGN FLOW 360 L.T.A.R. .25

Septic Tank: 1000 Gallons; STB 312 Date 4-30-06

Pump Tank: 1000 Gallons; PT 27 Date 4-30-06

Pump Make: Goulds Model WEC-712H Serial No.

Nitrification Field: No. Fields 1 Square Feet 720 Linear Feet 240

No. Lines 3 @ 80' Trench Width 2'3" Max Trench Bottom Depth 3 Gravel Depth N/A

[X] New System [ ] Repair System Type: I, II, III, (IV), V, VI

System Description: Pressure Dosed - 16" PPBAS

Repair System Description: Same Type

Maintenance Agreement Required: [X] Yes [ ] No

[X] House/Mod. Home No. Bedrooms 3

[ ] Mobile Home No. Bathrooms 4

[ ] Business No. Employees

[ ] Other

[ ] Slab [ ] Crawl Space [X] Basement w/plumbing [ ] Basement wo/plumbing


Water Supply: [ ] Individual [ ] Public [X] Community Kings Landing

Comments:/Conditions: * Maintenance Contract Required Mayure Single Valve Box w/ 3 valves; Note Dimensions Very Tight!

Comments:/Conditions: Goulds WEC-712H 3/4 HP. 3 ft head 3/16" holes / 55 Pounds Total

INITIAL SITE SKETCH

1" = 50'

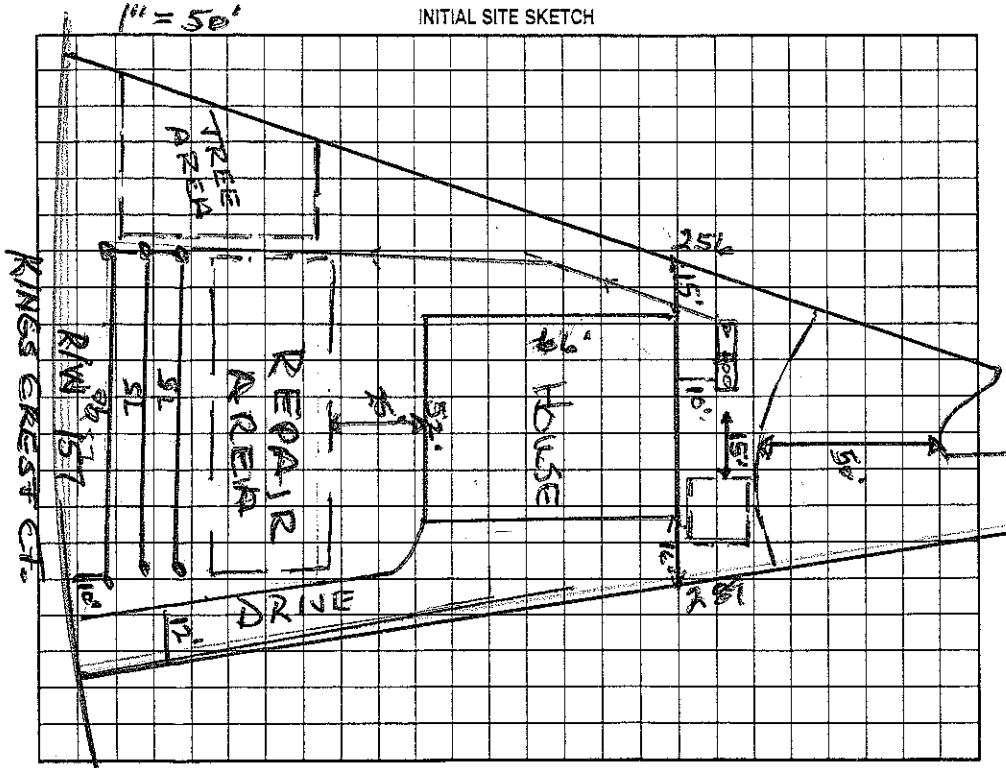

AS BUILT SKETCH

Permit can be suspended or revoked if any false information is supplied toward securing the permit/any unauthorized changes are made to the site/any unauthorized changes are made in the installation of the system. Improvement Permit with plat valid without expiration. Improvement Permit with site plan valid for sixty months. Authorization to Construct is valid for a period equal to that of Improvement Permit – not to exceed sixty months.

Signed: * [signature] date 6-1-05 Installed by: Osborne & Sons.

Improvement Permit by: Wesley Sparks RS date 5/9/05 Operation Permit by: Wesley Sparks RS. date 6/8/06

Authorization to Construct by: Wesley Sparks RS date 5/9/05 Existing System Inspection by: date

HEALTH DEPT. COPY: WHITE OWNER COPY (FINAL): YELLOW OWNER COPY (INITIAL): PINK