IREDELL COUNTY HEALTH DEPARTMENT

Authorization to Construct

STATESVILLE 704-878-5305 MOORESVILLE 704-664-5281

IMPROVEMENT PERMIT / ~~CERTIFICATE OF COMPLETION~~ / OPERATION PERMIT / EXISTING SYSTEM INSPECTION

PROPERTY DESCRIPTION NO. 65622 DATE 4/21/97 TAX MAP NO. ~~95~~ 4634984473 Watershed: X Yes ☐ No

OWNER OR CONTRACTOR Andrew Laczko PHONE: Business _____ Home 892-5877

ADDRESS 21038 Decora Dr. Cornelius, NC. 28031

LOCATION Langtry TL 2nd Knollview Lane to 16th lot on (12)

SUBDIVISION KINGS LANDING BLOCK / SECTION _____ LOT 15 LOT AREA 1.25AC SITE CLASS. PS DESIGN FLOW 600 L.T.A.R. .3

Septic Tank: 1500 Gallons; STB 797 Date 11/18/97

Pump Tank: 1500 Gallons; PT 797 Date 6/11/97

Pump Make: HYDROMATIC Model SK50A1 Serial No. 2198

Nitrification Field: No Fields 1 Square Feet ~~1500~~ Linear Feet ~~500~~ 400

No Lines 5 Trench Width 36" Max Trench Bottom Depth 36" Gravel Depth SAND.

X New System ☐ Repair System Type: I, II, (III) IV, V, VI

System Description: ~~Presbyter~~ - Ch. Plastic

Repair System Description: ~~+16"~~ Prof. Panel Block

Maintenance Agreement Required: ☐ Yes X No

X House/Mod. Home ☐ Mobile Home ☐ Business ☐ Other

No. Bedrooms 5 No. Bathrooms 5 No. Employees ____


☐ Slab X Crawl Space ☐ Basement w/plumbing ☐ Basement wo/plumbing

Water Supply: ☐ Individual X Community ☐ Public


Comments: ~~X~~ 25% Reduction per Ch. Plastic use

Comments: 3/25/98 Soil highly compacted since system layed out - AWS

INITIAL SITE SKETCH

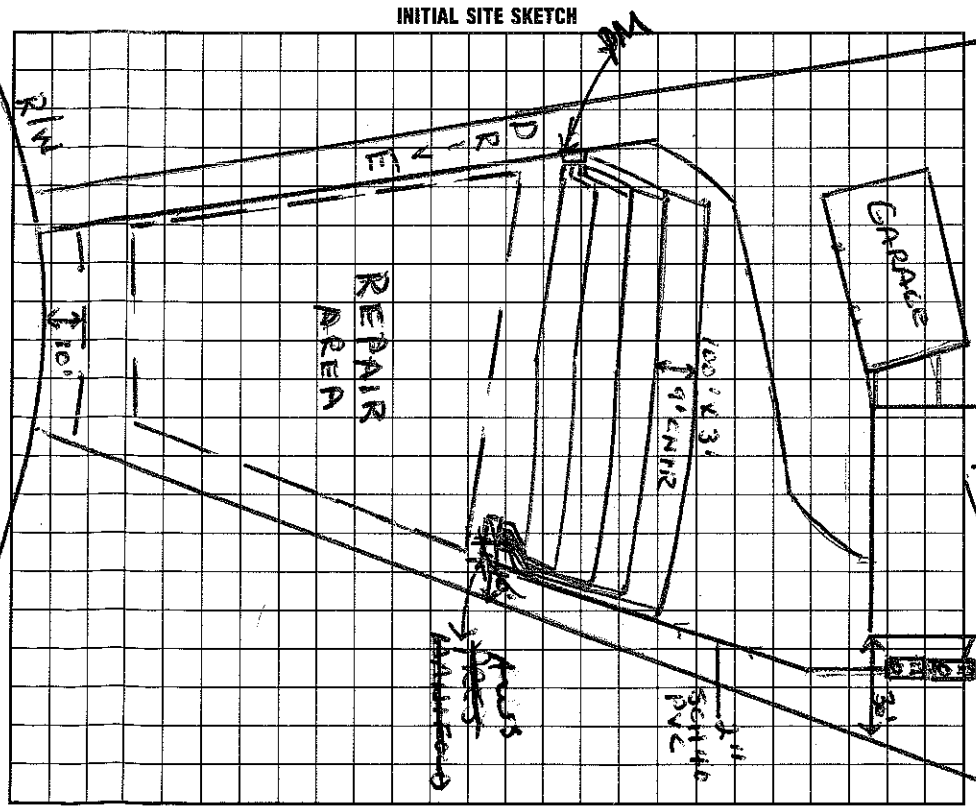

AS BUILT SKETCH

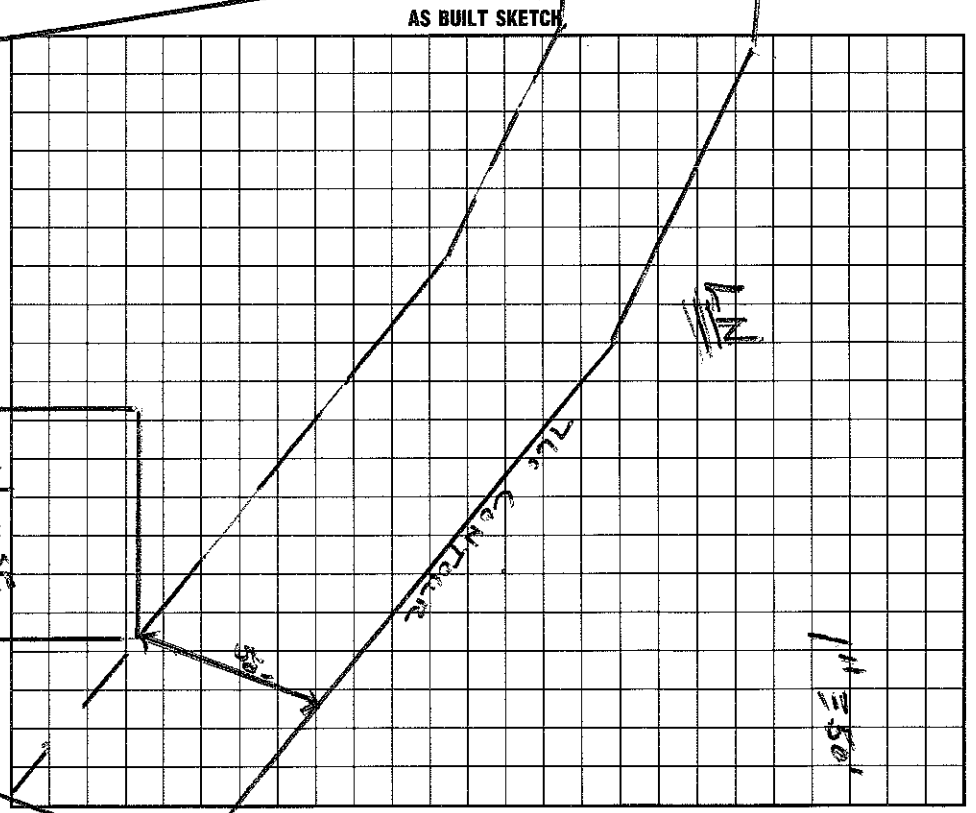

I understand that this permit can be suspended or revoked if any false information is supplied toward securing the permit/any unauthorized changes are made to the site/any unauthorized changes are made in the installation of the system. Improvement Permit is valid for 60 months from date of issuance.

Signed: X _____

Improvement Permit by: Wesley Sparks R.S. date 4/21/97

Existing System Inspection by: Wesley Sparks R.S. date 4/21/97

Installed by: MAYHEW

Certificate of Completion by: Wesley Sparks RS date 5/15/98

Operation Permit by: Wesley Sparks RS date 5/15/98

HEALTH DEPT. COPY: WHITE INSPECTION COPY (FINAL): GREEN OWNER COPY (FINAL): YELLOW INSPECTION COPY (INITIAL): PINK OWNER COPY (INITIAL): GOLD