IREDELL COUNTY HEALTH DEPARTMENT

STATESVILLE 704-878-5305 MOORESVILLE 704-664-5281

IMPROVEMENT PERMIT / CERTIFICATE OF COMPLETION / OPERATION PERMIT / EXISTING SYSTEM INSPECTION

PROPERTY DESCRIPTION NO. 21045 DATE 5/9/95 TAX MAP NO. 2B-5-A-16 4634 98 4557 Watershed: ☑ Yes ☐ No

OWNER OR CONTRACTOR Ch Dobson Bldrs PHONE: Business _____ Home 548-0669

ADDRESS 8200 Univesity Exec Park Char. NC. 28262

LOCATION Langtree Rd. TL on Knollview Ln., on (R) side after last driveway

SUBDIVISION Kings Landing BLOCK / SECTION _____ LOT 16 LOT AREA .94 AC SITE CLASS. P DESIGN FLOW 360 L.T.A.R. .5 x .3

Septic Tank: 1000 Gallons; STB 794 Date 12/14/95

Pump Tank: 1000 Gallons; PT 29 Date 12/15/95

Pump Make: LIBERTY Model LESIA Serial No. 2400

Nitrification Field: No Fields 1 Square Feet 1200 Linear Feet 300

No Lines 5 4 Trench Width 36" Max Trench Bottom Depth 36" Gravel Depth N/A

☐ New System ☐ Repair System Type: I, II, III, IV, V, VI

System Description: Pressure Manifold Infiltrator

Repair System Description: _____

Maintenance Agreement Required: ☐ Yes ☐ No

☑ House/Mod. Home No. Bedrooms 3

☐ Mobile Home No. Bathrooms 4

☐ Business No. Employees _____

☐ Other _____


☐ Slab ☐ Crawl Space ☐ Basement w/plumbing ☐ Basement wo/plumbing

Water Supply:
☐ Individual
☐ Community
☐ Public


Comments: Pressure Manifold to Infiltrator Drainfield

Comments: 118 (DOSE - 6" drawdown)
135 (DOSE - 7" drawdown)

INITIAL SITE SKETCH

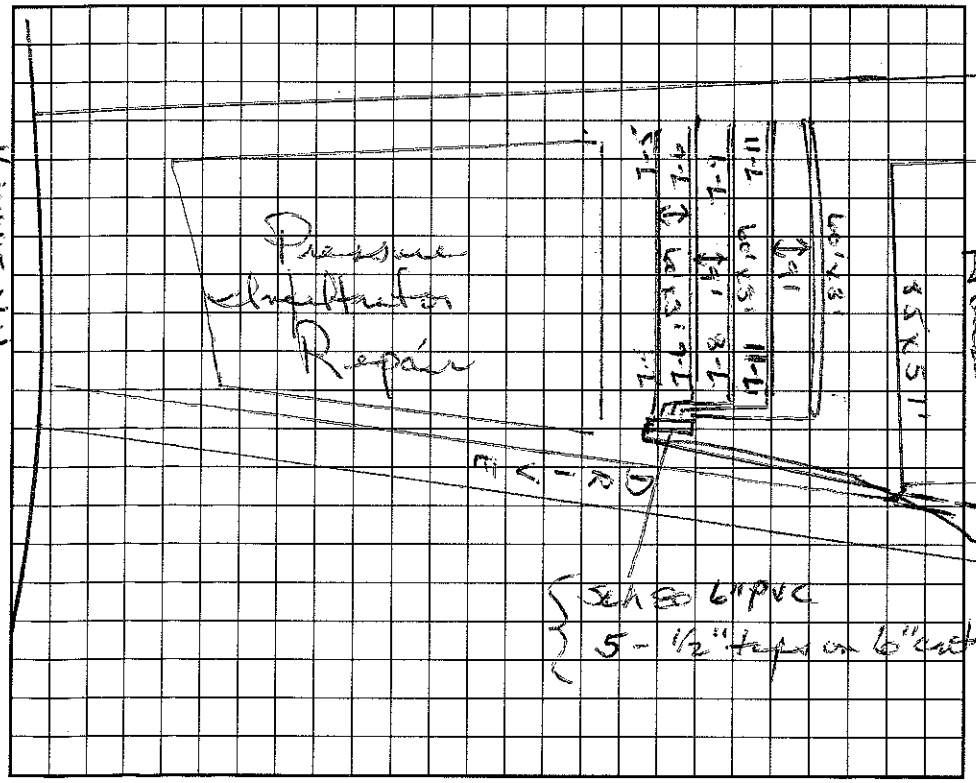

AS BUILT SKETCH

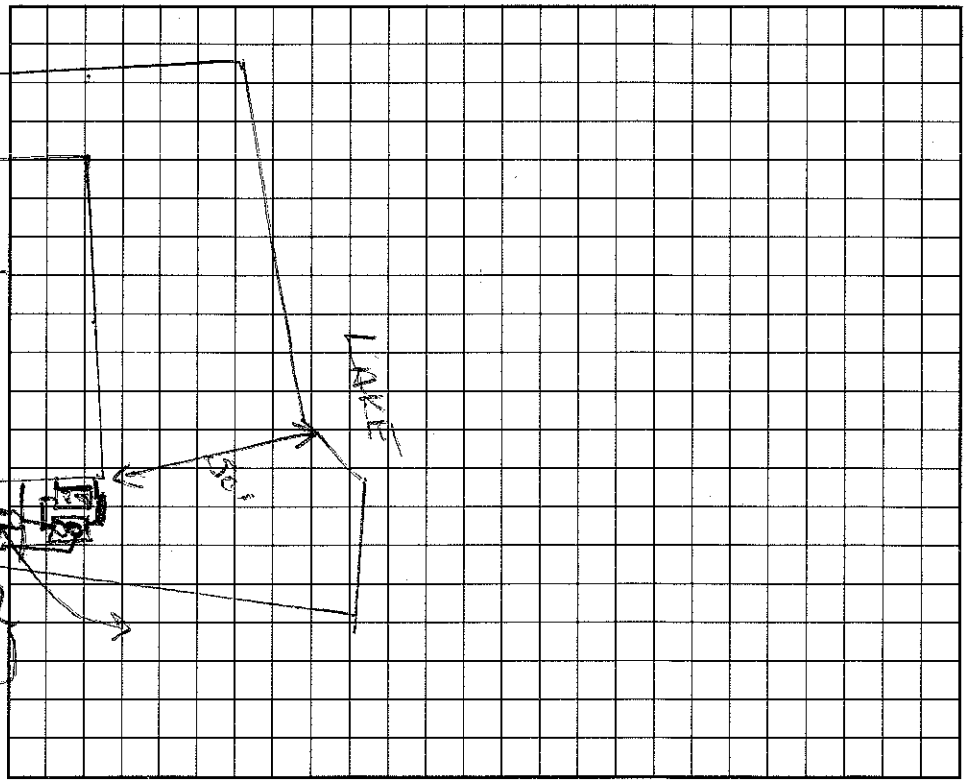

I understand that this permit can be suspended or revoked if any false information is supplied toward securing the permit/any unauthorized changes are made to the site/any unauthorized changes are made in the installation of the system. Improvement Permit is valid for 60 months from date of issuance.

Signed: _____

Improvement Permit by: Wesley Sparks RS. date 5/9/95

Existing System Inspection by: _____ date _____

Installed by: Bob Mayhew

Certificate of Completion by: _____ date _____

Operation Permit by: Wesley Sparks RS. date 5/14/96

HEALTH DEPT. COPY: WHITE INSPECTION COPY (FINAL): GREEN OWNER COPY (FINAL): YELLOW INSPECTION COPY (INITIAL): PINK OWNER COPY (INITIAL): GOLD