10:00

IREDELL COUNTY HEALTH DEPARTMENT

STATESVILLE 704-878-5305 MOORESVILLE 704-664-5281

IMPROVEMENT PERMIT / AUTHORIZATION TO CONSTRUCT / OPERATION PERMIT / EXISTING SYSTEM INSPECTION

PERMIT# 12229 PIN# 4634-98-4649 DATE 5/19/04

OWNER OR CONTRACTOR Diana R. McCarthy PHONE: Business Home 704-895-6092

ADDRESS 413 Northwest Dr. Davidson NC 28036

LOCATION 115 S, TR Langtree, TL 2nd Knoxview, on RT

SUBDIVISION King Landing BLOCK / SECTION LOT 17 LOT AREA 0.83 AC SITE CLASS. RS DESIGN FLOW 360 L.T.A.R. 0.25

Septic Tank: 1000 Gallons; STB 794 Date 10-29-04
Pump Tank: 1000 Gallons; PT 27 Date 10-30-04
Pump Make: Goulds Model WE0312MU Serial No. J0484921
Nitrification Field: No Fields 1 Square Feet 1080 Linear Feet 360
No Lines 4@90' Trench Width 36" Max Trench Bottom Depth 36" Gravel Depth —

☒ New System ☐ Repair System Type: I, II, III, IV, V, VI
System Description: PM 25% Reduction
Repair System Description: LA Pearl Block
Maintenance Agreement Required: ☐ Yes ☒ No


☒ House/Mod. Home No. Bedrooms 3
☐ Mobile Home No. Bathrooms 3½
☐ Business No. Employees
☐ Other
☐ Slab ☒ Crawl Space ☐ Basement w/plumbing ☐ Basement wo/plumbing

Water Supply: ☐ Individual ☐ Public ☒ Community


Comments:/Conditions: Checked tanks & lines 12/3/04 EZ Flow

Comments:/Conditions: Installed EZ Flow Drainfield

INITIAL SITE SKETCH

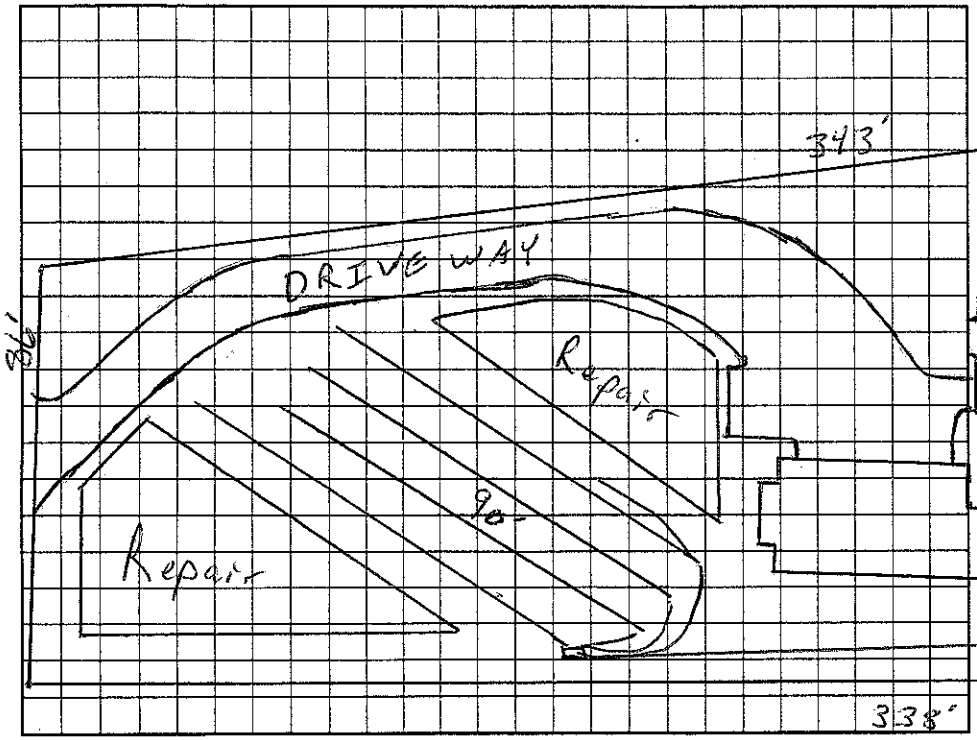

AS BUILT SKETCH 12/3/04

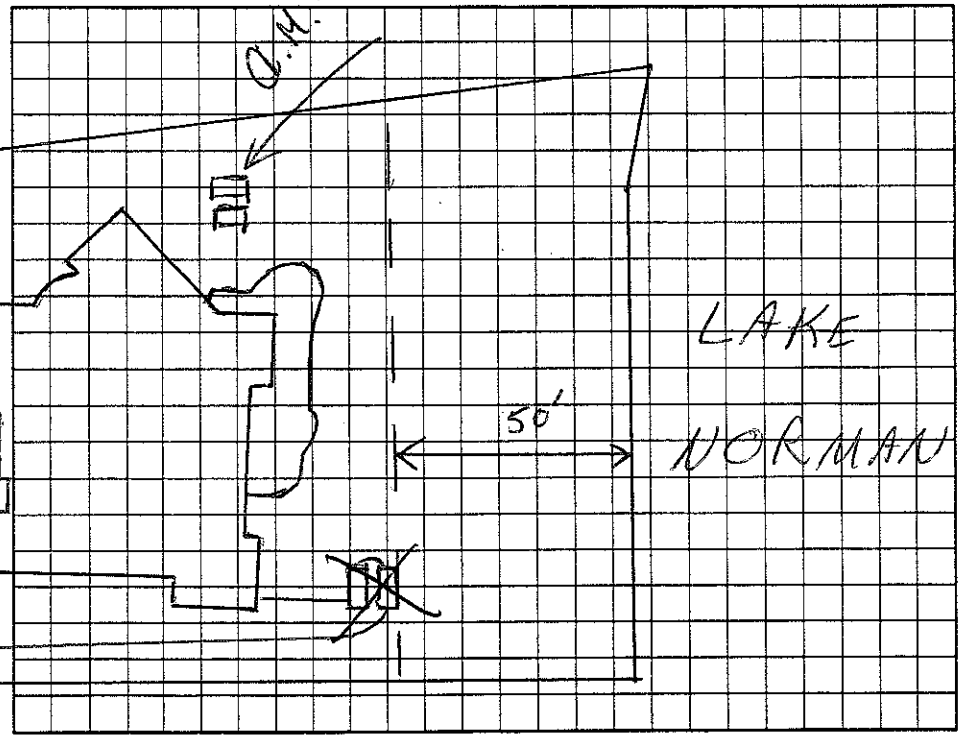

Permit can be suspended or revoked if any false information is supplied toward securing the permit/any unauthorized changes are made to the site/any unauthorized changes are made in the installation of the system. Improvement Permit with plat valid without expiration. Improvement Permit with site plan valid for sixty months. Authorization to Construct is valid for a period equal to that of Improvement Permit – not to exceed sixty months.

Signed: [signature] date 5-20-04 Installed by: R & H RS

Improvement Permit by: [signature] RS date 5/19/04 Operation Permit by: [signature] date 2/17/05

Authorization to Construct by: [signature] RS date 5/19/04 Existing System Inspection by: date

HEALTH DEPT. COPY: WHITE OWNER COPY (FINAL): YELLOW OWNER COPY (INITIAL): PINK