IREDELL COUNTY HEALTH DEPARTMENT

STATESVILLE 704-878-5305 MOORESVILLE 704-664-5281

IMPROVEMENT PERMIT / CERTIFICATE OF COMPLETION / OPERATION PERMIT / EXISTING SYSTEM INSPECTION

PROPERTY DESCRIPTION NO. 19855 DATE 1/5/95 Rev 5 TAX MAP NO. 2B-B-2 pt of. Watershed: ☒ Yes ☐ No

OWNER OR CONTRACTOR ~~Adrianne Mabe~~ (DALE SWARTZ) PHONE: Business 4634 98 4840 Home 663-6131

ADDRESS PO Box 830 Mooresville, N.C. 28115

LOCATION Langtree TL onto Knox view LN, on (R) just before culvert

SUBDIVISION Kingsbridge BLOCK / SECTION ____ LOT 18 LOT AREA 1.83 SITE CLASS. ? DESIGN FLOW 480 L.T.A.R. .35

Septic Tank: 1000 Gallons; STB 794 Date 4/9/96

Pump Tank: 1000 Gallons; PT 29 Date 4/23/96

Pump Make: ____ Model ____ Serial No. 350'

Nitrification Field: No. Fields 1 Square Feet 1371 Linear Feet 459

No Lines ~~4~~ (5) Trench Width 36" Max Trench Bottom Depth 36" Gravel Depth ~~12" STONE~~

☒ New System ☐ Repair System Type: I, II, (III), IV, V, VI

System Description: Pressure - Conventional

Repair System Description: Same Ch. Plastic

Maintenance Agreement Required: ☒ Yes ☐ No

☒ House/Mod. Home ☐ Mobile Home ☐ Business ☐ Other

No. Bedrooms 4 No. Bathrooms 3 No. Employees ____


☐ Slab ☒ Crawl Space ☐ Basement w/plumbing ☐ Basement wo/plumbing

Water Supply: ☒ Individual ☐ Community ☐ Public


Comments: Washer w/ gate valve inside
Normal installation of pump, Alarm, connection
Leaf
Not more than 180 gallons per dose

Comments:
5/29/96 - OK'd by phone with B Mayhew

INITIAL SITE SKETCH

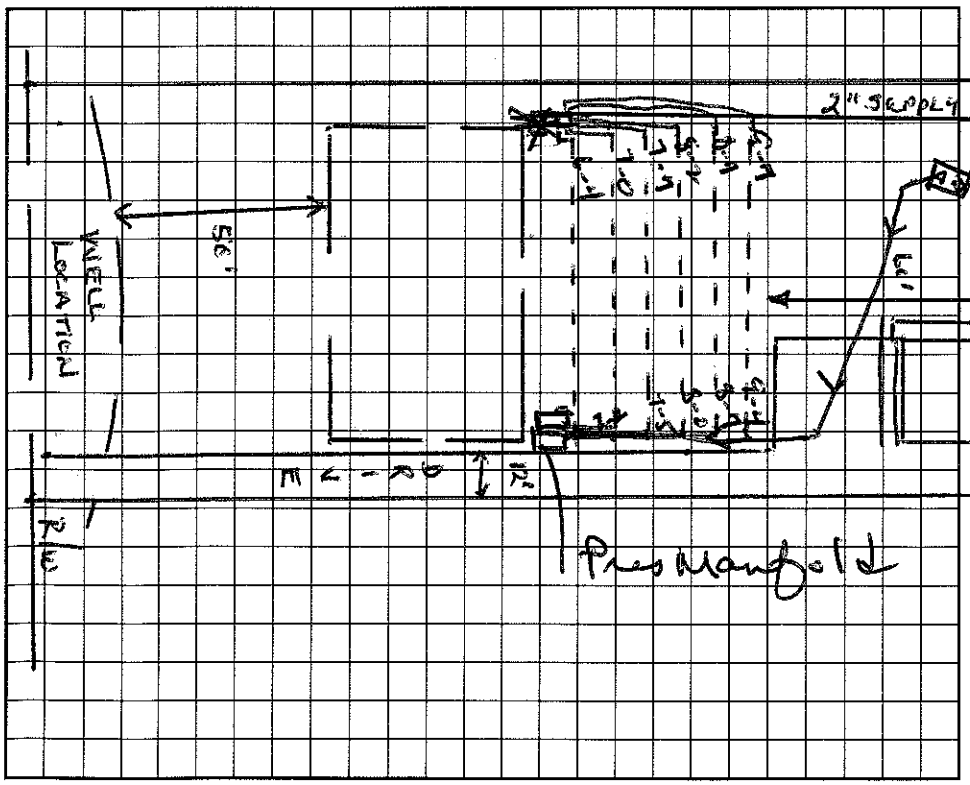

AS BUILT SKETCH

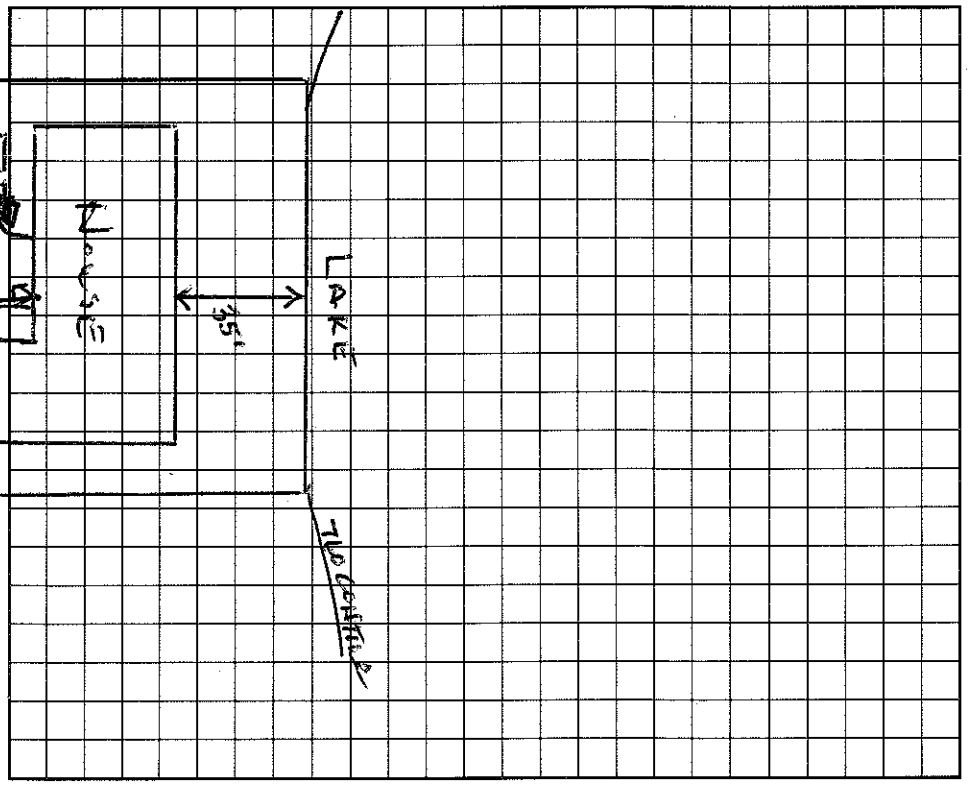

I understand that this permit can be suspended or revoked if any false information is supplied toward securing the permit/any unauthorized changes are made to the site/any unauthorized changes are made in the installation of the system. Improvement Permit is valid for 60 months from date of issuance.

Signed: Carolyn Walker

Improvement Permit by: Wesley Sparks R.S. date 1/5/95

Existing System Inspection by: ____ date ____

Installed by: Bob Mayhew

Certificate of Completion by: ____ date ____

Operation Permit by: Wesley Sparks R.S. date 8/19/96

HEALTH DEPT. COPY: WHITE INSPECTION COPY (FINAL): GREEN OWNER COPY (FINAL): YELLOW INSPECTION COPY (INITIAL): PINK OWNER COPY (INITIAL): GOLD