IREDELL COUNTY HEALTH DEPARTMENT

Authorization to Construct

STATESVILLE 704-878-5305 MOORESVILLE 704-664-5281

IMPROVEMENT PERMIT / CERTIFICATE OF COMPLETION / OPERATION PERMIT / EXISTING SYSTEM INSPECTION

PROPERTY DESCRIPTION NO. 25884 DATE 3/27/97 TAX MAP NO. 463498 5321 Watershed: X Yes ☐ No

OWNER OR CONTRACTOR JAMES T. WILSON PHONE: Business _____ Home 663-5444

ADDRESS PO 1046 Mooresville, NC. 28115

LOCATION Langtree TL 2ND Knollview on (R) in curve on peninsula

SUBDIVISION KINGS LANDING BLOCK / SECTION _____ LOT 14 LOT AREA 1.2 AC SITE CLASS. #5 DESIGN FLOW 480 L.T.A.R. .3

Septic Tank: 1250 Gallons; STB 794 Date 2/25/98

Pump Tank: 1000 Gallons; PT 27 Date 4/2/98

Pump Make: HYDROMATIC Model SKE 1-50A1 Serial No. 5/98

Nitrification Field: No. Fields 1 Square Feet 1200* Linear Feet 400*

No. Lines 5(4) Trench Width 36" Max Trench Bottom Depth 30" Gravel Depth SAND

X New System ☐ Repair System Type: I, II, III, IV, V, VI

System Description: #CN PLAS - PRES MANIFOLD

Repair System Description: _____

Maintenance Agreement Required: ☐ Yes ☐ No

X House/Mod. Home No. Bedrooms 4

☐ Mobile Home No. Bathrooms 3

☐ Business No. Employees _____

X Other BAR DISPOSAL

☐ Slab X Crawl Space ☐ Basement w/plumbing ☐ Basement wo/plumbing

Water Supply: ☐ Individual X Community ☐ Public


Comments: 10/2/97 - New Home location - Lowering Ch. Plastic may be used behind house 4@ 100' x 3' Ans

Comments: 266 - 16" PPBS. - L2 PANELS {704-696-2000 / 704-667-5802}


150 GAL 7.5" Drawdown 5 lines install'd.

No Pressure Manifold

INITIAL SITE SKETCH

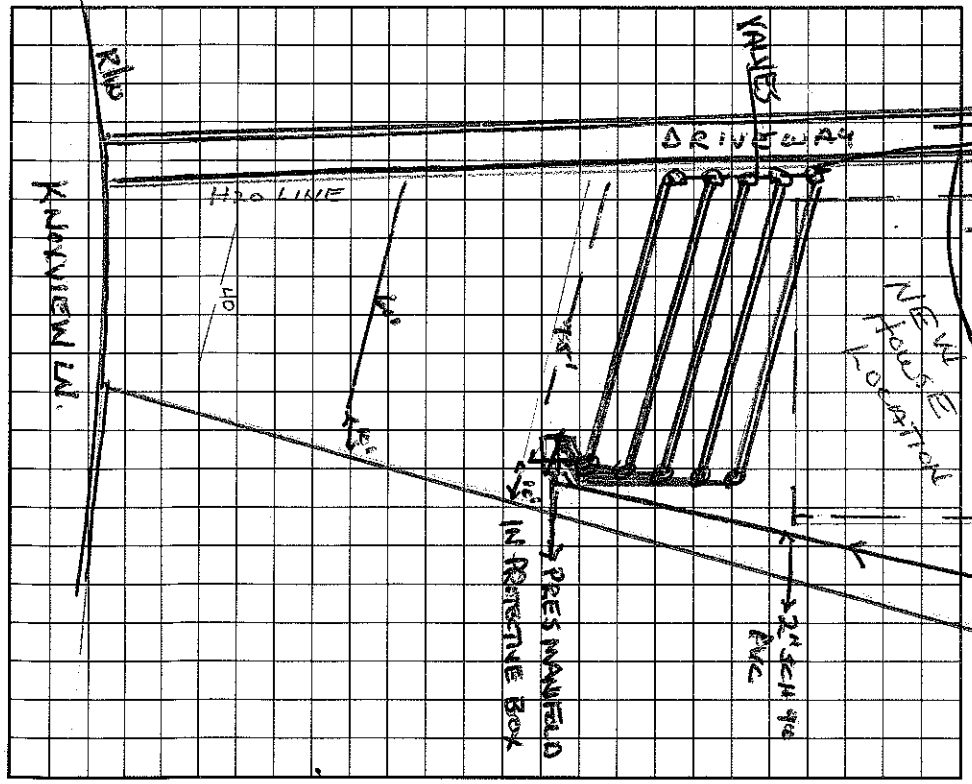

AS BUILT SKETCH

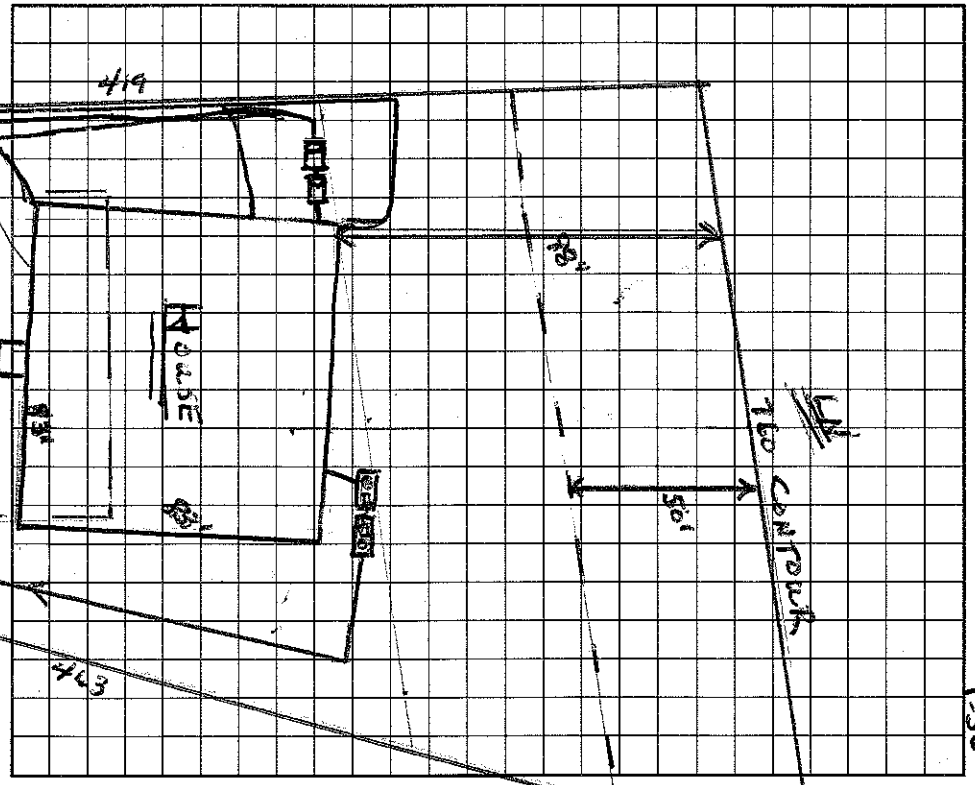

I understand that this permit can be suspended or revoked if any false information is supplied toward securing the permit/any unauthorized changes are made to the site/any unauthorized changes are made in the installation of the system. Improvement Permit is valid for 60 months from date of issuance.

Signed: JAMES T. WILSON

Improvement Permit by: Wesley Sparks R.S. date 3/27/97

Existing System Inspection by: Agent for Wesley Sparks R.S. date 3/27/97

Installed by: Agent Dunning

Certificate of Completion by: Wesley Sparks R.S. date 6/24/98

Operation Permit by: Wesley Sparks R.S. date 6/24/98

HEALTH DEPT. COPY: WHITE INSPECTION COPY (FINAL): GREEN OWNER COPY (FINAL): YELLOW INSPECTION COPY (INITIAL): PINK OWNER COPY (INITIAL): GOLD