IREDELL COUNTY HEALTH DEPARTMENT

AUTHORIZATION TO CONSTRUCT (10:30) 10:30

STATESVILLE 704-878-5305 MOORESVILLE 704-664-5281

IMPROVEMENT PERMIT / ~~CERTIFICATE OF COMPLETION~~ / OPERATION PERMIT / EXISTING SYSTEM INSPECTION

PROPERTY DESCRIPTION NO. 20048 DATE 4/2/97 TAX MAP NO ~~pt 4 2BB2~~ 4634-98-7274 Watershed: ☑ Yes ☐ No

OWNER OR CONTRACTOR KARLON YOUNG PHONE: Business _____ Home _____

ADDRESS 621 FAITH RD MOORESVILLE

LOCATION 115 S. TR LANDTREE TL KNOXVIEW RD. [redacted] ≈ ¼ MILE ON RT

SUBDIVISION KINGS LANDING BLOCK / SECTION _____ LOT 12 LOT AREA 1.23AC SITE CLASS. PS DESIGN FLOW 480 GPD L.T.A.R. .3 GPD/FT²

Septic Tank: 1000 Gallons; STB 97 Date 2/13/97
Pump Tank: 1000 Gallons; PT 71 Date 1/11/97
Pump Make: MYERS Model #ME40 Serial No. _____
Nitrification Field: No Fields 1 Square Feet 536 Linear Feet 268
No Lines 4@67' Trench Width 24" Max Trench Bottom Depth 30" Gravel Depth N/A

☑ New System ☐ Repair System Type: I, II, III (IV) V, VI
System Description: LPPPBPS
Repair System Description: SAME
Maintenance Agreement Required: ☑ Yes ☐ No

☑ House/Mod. Home No. Bedrooms 4
☐ Mobile Home No. Bathrooms 6
☐ Business No. Employees _____
☐ Other _____


☐ Slab ☑ Crawl Space ☐ Basement w/plumbing ☐ Basement wo/plumbing

Water Supply:
☐ Individual
☑ Community
☐ Public

Comments: (REVISED PLAN) 18 FT TRN.

Comments: LINES TANKS, PRESSURE CHECKED 4/10/97

INITIAL SITE SKETCH

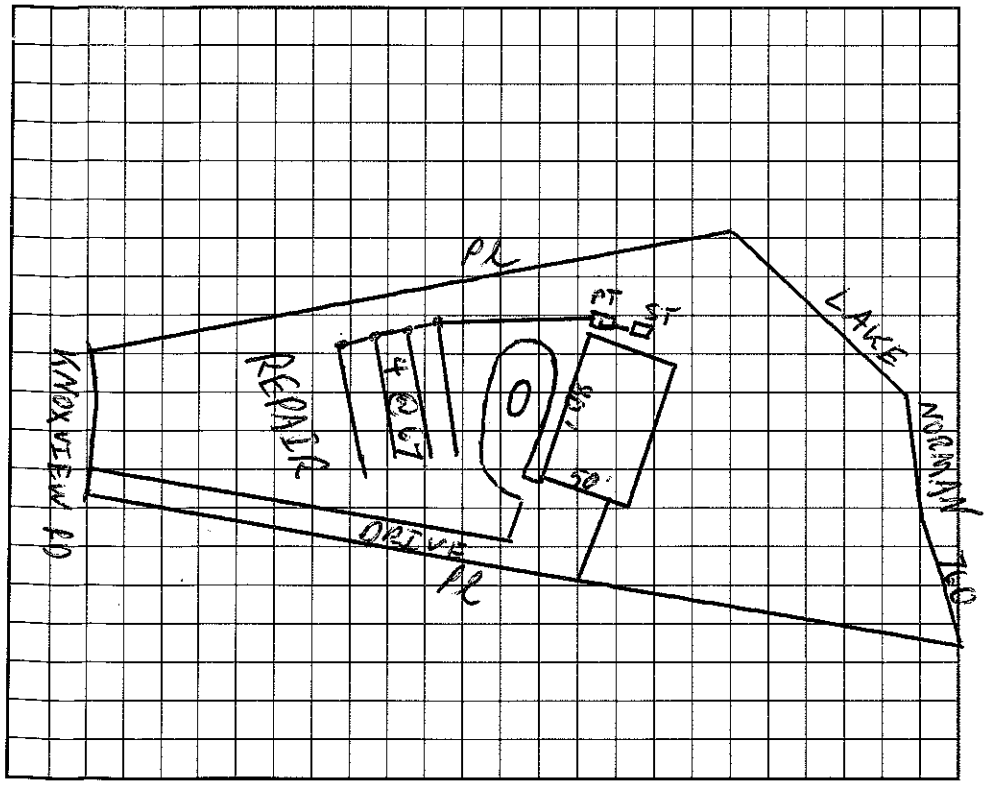

AS BUILT SKETCH

SAME AS SITE SKETCH.

I understand that this permit can be suspended or revoked if any false information is supplied toward securing the permit/any unauthorized changes are made to the site/any unauthorized changes are made in the installation of the system. Improvement Permit is valid for 60 months from date ~~of issuance~~.

Signed: [signature]

Installed by: HOWELL GRADING

Improvement Permit by: C. [signature] EHSE date 4/2/97

Certificate of Completion by: _____ date _____

AUTHORIZATION TO CONSTRUCT ~~Existing System Inspection by:~~ C. [signature] EHSE date 4/2/97

Operation Permit by: C. [signature] date 7/15/97

HEALTH DEPT. COPY: WHITE INSPECTION COPY (FINAL): GREEN OWNER COPY (FINAL): YELLOW INSPECTION COPY (INITIAL): PINK OWNER COPY (INITIAL): GOLD